

WORKS INSTRUCTION SHEET

WORK DESCRIPTION:

In order to provide electrical reticulation to Stages 7B, 7C, 9A & 9C, refer to Connetics working drawings 107004, HV, LV & SL schematics

1. Install two full kiosks fitted with 200kVA transformers.
2. Lay 11kV and 400V cables
3. Carry out 11kV & 400V cable thru joints
4. Terminate all cables, complete test certificates & label circuits.
5. Liven all Circuits only after clearance from Orion's Contract Manager.
6. Test earthing to ensure compliance.
7. All Work shall comply with Orion NZ Ltd's Design Standards and Specifications
8. Customer service mains to be connected in accordance with the Electrical Safety Regulations.

PREPARED BY: Brenda Cavalcante
DATE PREPARED: 24/11/2025
ORION CONTRACT MANAGER: M. Williams
ORN NUMBER: ORN1008854
WORK ORDER NUMBER:

Cable lengths are indicative only

SUBSTATION DETAILS

Size	Switchgear	CCT	Cable			Comments
			Cable Size	New/Ex	Circuit Destination	
OFF TRENTS RD LOT 111 - C13/1044						
NEW 3K1T MSU			185AI 3C 11kV 185AI 3C 11kV 185AI 3C 11kV 3-25AI 1C 11kV	New New New New	Insulated end Lot 110 Off Trents Rd, Lot 96 cct.52 Off Trents Rd, Lot 1000 cct.52 Local Transformer	Install new full kiosk in Orion title site. Fit with a 3K1T MSU & 200kVA transformer. Earthing to Orion Technical Spec. NW70.59.01
16A	Links	51				Terminate and connect new cable, trifurcated to singles. Label circuit destination
	Links	52				Terminate and connect new cable, trifurcated to singles. Label circuit destination
	Links	53				Terminate and connect new cable, trifurcated to singles. Label circuit destination
	Fuses	54				Install 25mmAl single HV leads between MSU and TX.
NEW 800A DIN TYPE LV PANEL			6mm	New - New New New New New New New -	Insulated end Lot 110 DB Lot 110 SW Local Transformer Insulated end Lot 109B Off Trents Rd, Lot 96 cct.3 DB Lot 111 NE - -	Install 800Amp LV DIN panel. Fit with 630A incomer and 6 equipped circuits. Install LV monitoring equipment as per NW72.22.22. Install lighting as per NW72.22.20.
Local service	32A fuse	-				Install local service panel UE2.11.4.
-	-	-				Fit cover kit.
630A	500Amp fuses	2				Terminate and connect new cable, label circuit destination.
630A	500Amp fuses	3				Terminate and connect new cable, label circuit destination.
630A	630Amp Links	Incomer				Fit set of leads between transformer LV bushings and LV panel.
630A	500Amp fuses	4				Terminate and connect new cable, label circuit destination.
630A	500Amp fuses	5				Terminate and connect new cable, label circuit destination.
630A	500Amp fuses	6				Terminate and connect new cable, label circuit destination.
-	Not equipped	-				Fit cover kit.
-	Generator Way	Gen.				Fit Generator spare way cover kit.

Street lighting: Install SL panel as per UE1.1.6. Terminate 5 SL pilots & 1 SL cable

OFF TRENTS RD LOT 138 - C13/1042

NEW 3K1T MSU			185AI 3C 11kV 185AI 3C 11kV 185AI 3C 11kV 3-25AI 1C 11kV	New New New New	Insulated end Lot 403 Off Trents Rd, Lot 1000 cct.53 Insulated end Lot 142 Local Transformer	Install new full kiosk in Orion title site. Fit with a 3K1T MSU & 200kVA transformer. Earthing to Orion Technical Spec. NW70.59.01
16A	Links	51				Terminate and connect new cable, trifurcated to singles. Label circuit destination
	Links	52				Terminate and connect new cable, trifurcated to singles. Label circuit destination
	Links	53				Terminate and connect new cable, trifurcated to singles. Label circuit destination
	Fuses	54				Install 25mmAI single HV leads between MSU and TX.
NEW 800A DIN TYPE LV PANEL			6mm - 300AI 3C+1 CuNS LV 300AI 3C+1 CuNS LV 4-185Cu 1C LV 300AI 3C+1 CuNS LV 300AI 3C+1 CuNS LV 300AI 3C+1 CuNS LV - -	New - New New New New New New -	DB Lot 137 Insulated end Lot 403 Local Transformer Off Trents, Lot 146B cct.2 Insulated end Lot 142 -	Install 800Amp LV DIN panel. Fit with 630A incomer and 4 equipped circuits. Install LV monitoring equipment as per NW72.22.22. Install lighting as per NW72.22.20.
Local service	32A fuse	-				Install local service panel UE2.11.4.
-	Not equipped	-				Fit cover kit.
630A	500Amp fuses	2				Terminate and connect new cable, label circuit destination.
630A	500Amp fuses	3				Terminate and connect new cable, label circuit destination.
630A	630Amp Links	Incomer				Fit set of leads between transformer LV bushings and LV panel.
630A	500Amp fuses	4				Terminate and connect new cable, label circuit destination.
630A	500Amp fuses	5				Terminate and connect new cable, label circuit destination.
630A	Not equipped	-				Fit cover kit.
-	Not equipped	-				Fit cover kit.
-	Generator Way	Gen.				Fit Generator spare way cover kit.

Street lighting: Install SL panel as per UE1.1.6. Terminate 4 SL pilots & 1 SL cable

Notes:

ACCEPTED

by Mark Williams on: 04 06 2026, 11:57 am

Orion

Accepted For Construction

Name:
Position:
Date:



Connetics Ltd.
All Rights Reserved
Unauthorised Use Prohibited

ISSUE
A

232 HAMPTONS RD - STAGE 7B, 7C, 9A
& 9C

50 LOT RESIDENTIAL SUBDIVISION



JOB No.

107004

Sheet


WIS-01

Engineering Design, Connetics Ltd

PO Box 2237 Christchurch New Zealand. Ph. (03) 353 7200

WORKS INSTRUCTION SHEET

OFF TRENTS RD LOT 96 - C81/29										
NEW 2K1T MSU			185AI 3C 11kV 185AI 3C 11kV 3-25AI 1C 11kV	New New New	OH Trents Rd C13/1040 Off Trents Rd, Lot 111 cct.52 Local Transformer	Install new full kiosk in Orion title site. Fit with a 2K1T MSU & 200kVA transformer. Earthing to Orion Technical Spec. NW70.59.01 Terminate and connect new cable, trifurcated to singles. Label circuit destination Terminate and connect new cable, trifurcated to singles. Label circuit destination Install 25mmAI single HV leads between MSU and TX.				
16A	Links	51								
	Links	52								
	Fuses	53								
NEW 800A DIN TYPE LV PANEL			6mm - 300AI 3C+1 CuNS LV 300AI 3C+1 CuNS LV 4-185Cu 1C LV 300AI 3C+1 CuNS LV - - -	New - New New New - - -	Off Trents Rd, Lot 73 cct.4 Off Trents Rd, Lot 111 cct.5 Local Transformer DB Lot 97A - - -	Install 800Amp LV DIN panel. Fit with 630A incomer and 4 equipped circuits. Install LV monitoring Install local service panel UE2.11.4. Fit cover kit. Terminate and connect new cable, label circuit destination. Terminate and connect new cable, label circuit destination. Fit set of leads between transformer LV bushings and LV panel. Terminate and connect new cable, label circuit destination. Spare for future Fit cover kit. Fit cover kit. Fit Generator spare way cover kit.				
Local service	32A fuse	-								
-	Not equipped	-								
630A	Open	2								
630A	Open	3								
630A	630Amp Links	Incomer								
630A	500Amp fuses	4								
630A	Open	5								
630A	Not equipped	-								
-	Not equipped	-								
	Generator Way	Gen.								
Street lighting: Install SL panel as per UE1.1.6. Terminate 4 SL pilots										
OFF TRENTS RD LOT 1000 - C82/22										
EX 3K1T MSU			185AI 3C 11kV 185AI 3C 11kV	Ex Ex	Off Trents Rd, Lot 111 cct.53 Off Trents Rd, Lot 138 cct.52	Ex Kiosk. Relabel circuit destination Relabel circuit destination				
	Links	52								
	Links	53								
EX 800A DIN TYPE LV PANEL						Ex 800Amp LV DIN panel				
630A	500Amp fuses	4	300AI 3C+1 CuNS LV	Ex	Off Trents, Lot 146B cct.3	Relabel circuit destination.				
OFF TRENTS RD LOT 73 - C13/1041										
EX 800A DIN TYPE LV PANEL						Ex 800Amp LV DIN panel				
630A	500Amp fuses	4	300AI 3C+1 CuNS LV	Ex	Off Trents Rd, Lot 96 cct.2	Relabel circuit destination.				
DISTRIBUTION CABINET DETAILS										
Size	Switchgear	CCT	Cable			Comments				
			Cable Size	New/Ex	Circuit Destination					
OFF TRENTS LOT 146B - C81/30										
630A	Links	1	300AI 3C+1 CuNS LV	New	DB Lot 143A	Install new distribution cabinet (M1). Equip 3 ways.				
630A	Links	2	300AI 3C+1 CuNS LV	New	Off Trents Rd Lot 138 cct.4	Terminate and connect new cable, label circuit destination.				
630A	Open	3	300AI 3C+1 CuNS LV	New	Off Trents Rd Lot 1000 cct.4	Terminate and connect new cable, label circuit destination.				
-	Spare	-	-	-	-	Fit cover kit.				
Street lighting: Terminate 3 SL pilots & 1 SL cable										
Notes: ACCEPTED by Mark Williams on: 04 06 2026, 11:57 am Orion				Accepted For Construction			232 HAMPTONS RD - STAGE 7B, 7C, 9A & 9C			
				Name:			50 LOT RESIDENTIAL SUBDIVISION		connetics ALL WAYS CONNECTING	
				Position:						
				Date:			© Connetics Ltd. All Rights Reserved Unauthorised Use Prohibited		JOB No. 107004 Sheet WIS-02	
			ISSUE							
			B							

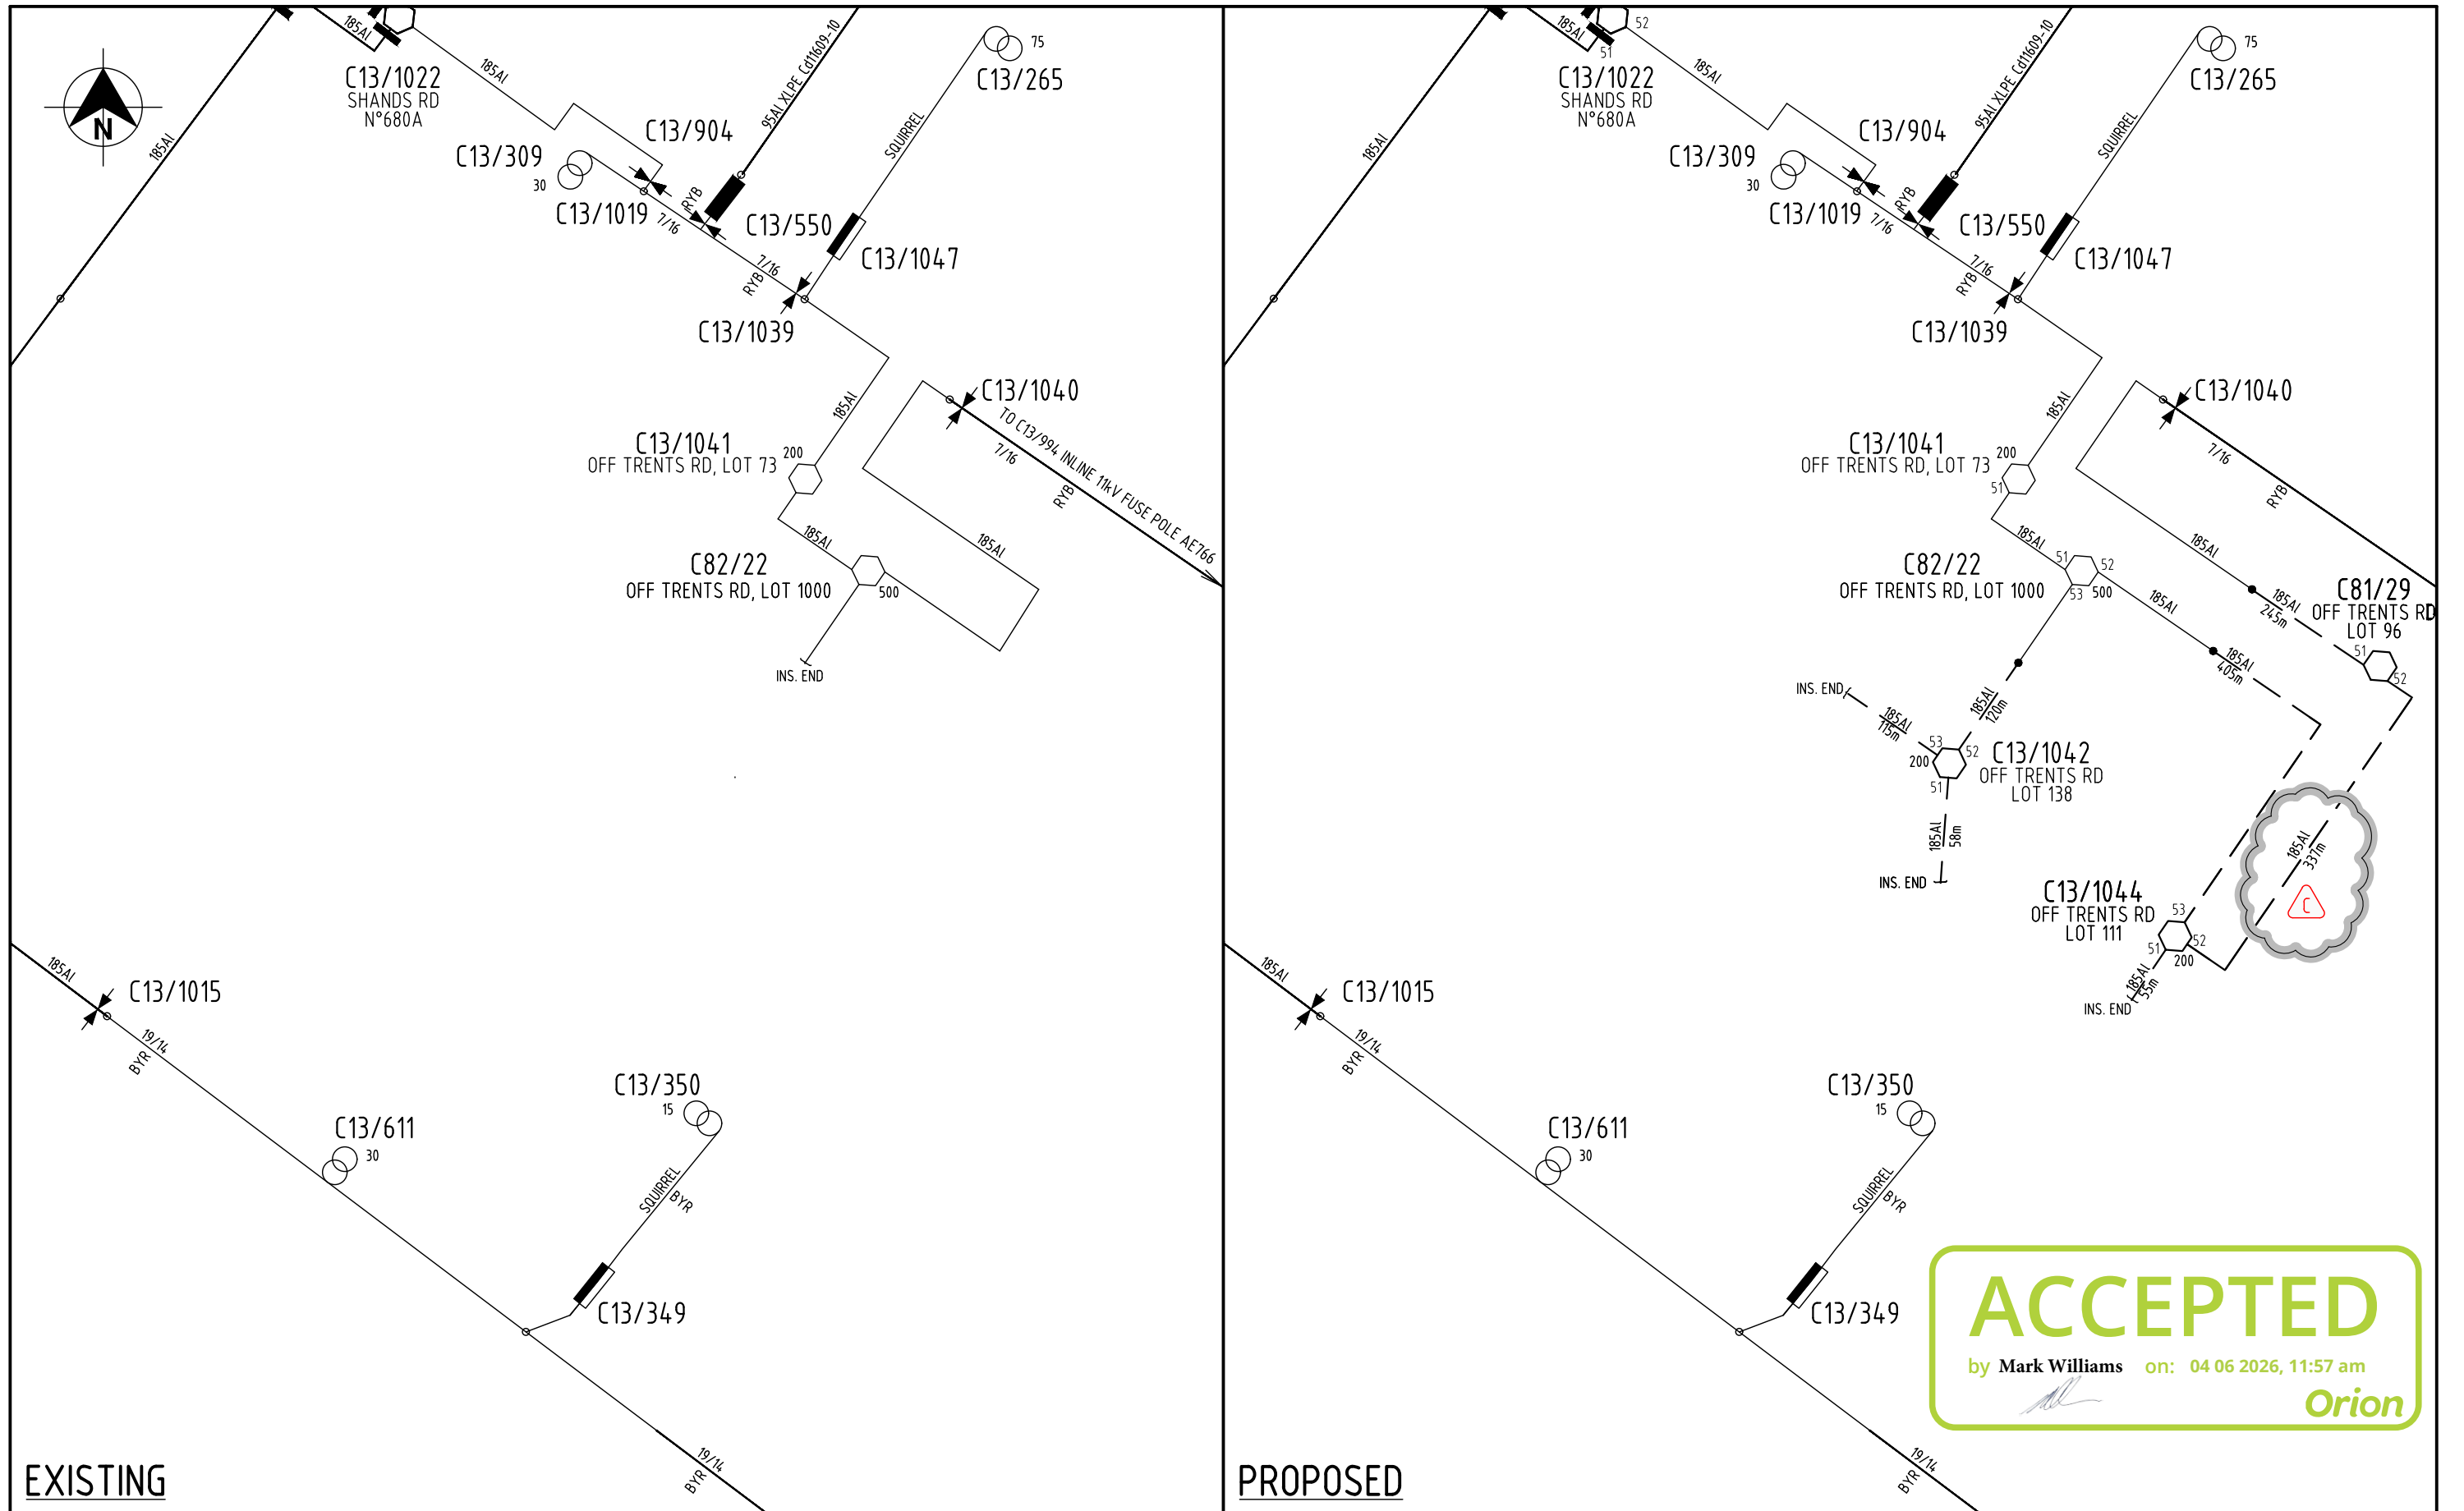


ACCEPTED
by Mark Williams on: 04 06 2026, 11:57 am
Orion

ISSUE	DESCRIPTION	DATE	DESIGN	DRAWN	CHECKD	TASK	NAME	SIGNATURE	DATED
A	ORIGINAL ISSUE	03/11/25	B.C.	B.C.	M.O	DESIGNED	B. CAVALCANTE		16/06/25
B	KIOSK MOVED TO NORTH OF LOT 96	24/11/25	B.C	B.C	M.O	DRAWN	B. CAVALCANTE		16/06/25
C	HV CABLE RELOCATED	03/06/26	B.C	B.C	M.O	CHECKED	M. OPHUIS		03/11/25
						APPROVED			
						ORN1008854	CONNETICS LIMITED: ALL RIGHTS RESERVED UNAUTHORISED USE PROHIBITED		C

232 HAMPTONS RD-STAGES 7B, 7C, 9A & 9C		 ALL WAYS CONNECTING	
50 LOT RESIDENTIAL SUBDIVISION HV SCHEMATICS - EXISTING/PROPOSED			
SCALE(SIZE)	DRAWING NO.	SHEET	
NTS (A3)	107004	HV-01	

EXISTING

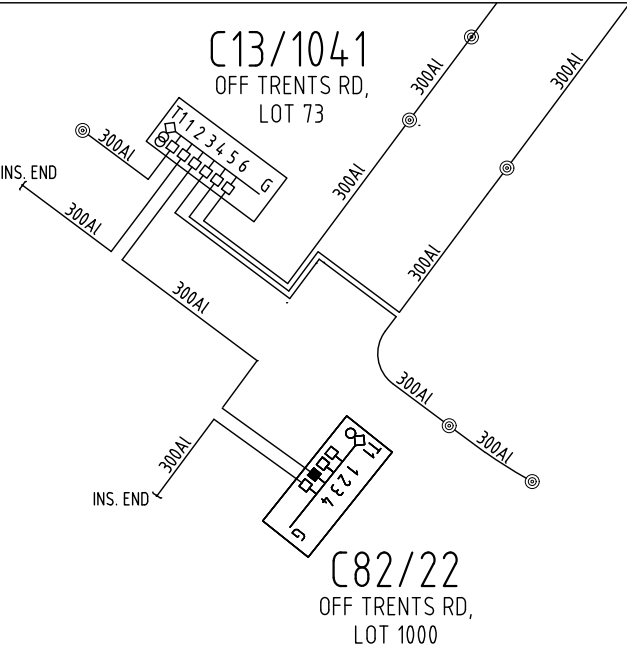

ACCEPTED


by Mark Williams on: 04 06 2026, 11:57 am

Orion

ISSUE	DESCRIPTION	DATE	DESIGN	DRAWN	CHECKD	TASK	NAME	SIGNATURE	DATED	232 HAMPTONS RD-STAGE 7B, 7C, 9A & 9C	 ALL WAYS CONNECTING	
A	ORIGINAL ISSUE	03/11/25	B.C	B.C	M.O	DESIGNED	B. CAVALCANTE		18/06/25			
						DRAWN	B.CAVALCANTE		18/06/25			
						CHECKED	M. OPHUIS		03/11/25			
						APPROVED						
						ORN1008854	 CONNETICS LIMITED. ALL RIGHTS RESERVED UNAUTHORISED USE PROHIBITED		A	RESIDENTIAL SUBDIVISION LV SCHEMATICS - EXISTING		
										SCALE(SIZE)	DRAWING NO.	SHEET
										NTS(A3)	107004	LV-01

PROPOSED

50 NEW CONNECTIONS

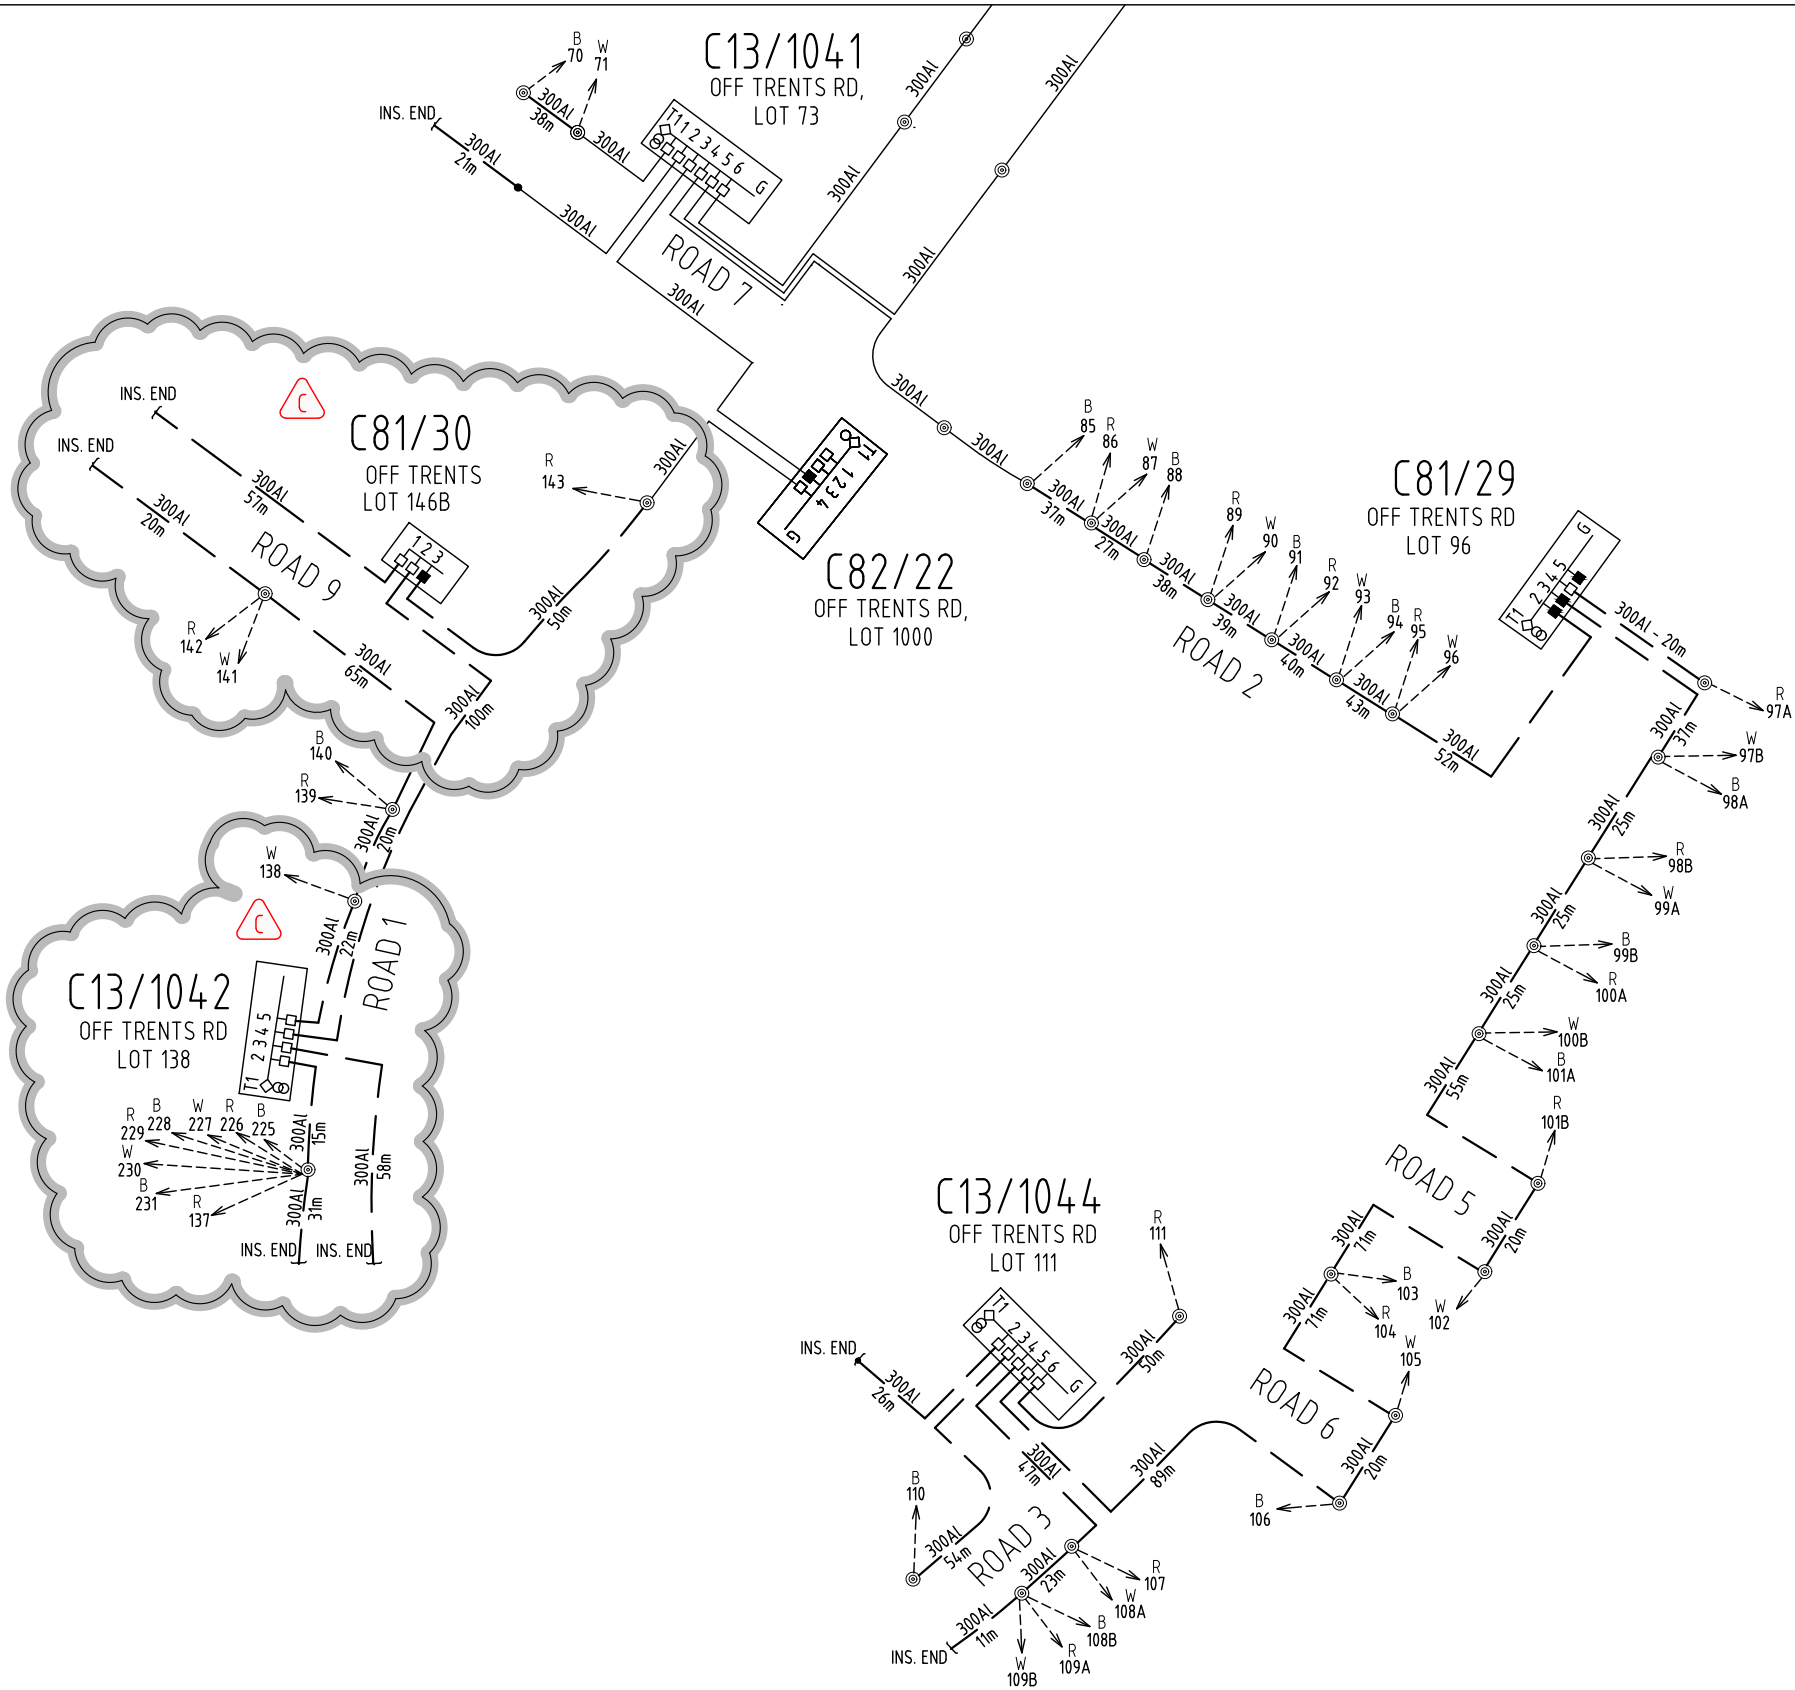

ACCEPTED

by Mark Williams on: 04 06 2026, 11:57 am

Orion

ISSUE	DESCRIPTION	DATE	DESIGN	DRAWN	CHECKD	TASK	NAME	SIGNATURE	DATED
A	ORIGINAL ISSUE	03/11/25	B.C	B.C	M.O	DESIGNED	B. CAVALCANTE		18/06/25
B	KIOSK MOVED TO NORTH OF LOT 96	24/11/25	B.C	B.C	M.O	DRAWN	B. CAVALCANTE		18/06/25
C	SL LOCATIONS UPDATED, STAGE 9C MODIFIED & STAGE 13 ADDED	03/06/26	B.C	B.C	M.O	CHECKED	M. OPHUIS		03/11/25
						APPROVED			
						ORN1008854	 CONNETICS LIMITED. ALL RIGHTS RESERVED UNAUTHORISED USE PROHIBITED		C


232 HAMPTONS RD-STAGE 7B, 7C, 9A & 9C

RESIDENTIAL SUBDIVISION
LV SCHEMATICS - PROPOSED



SCALE(SIZE)	DRAWING NO.	SHEET
NTS(A3)	107004	LV-02

EXISTING

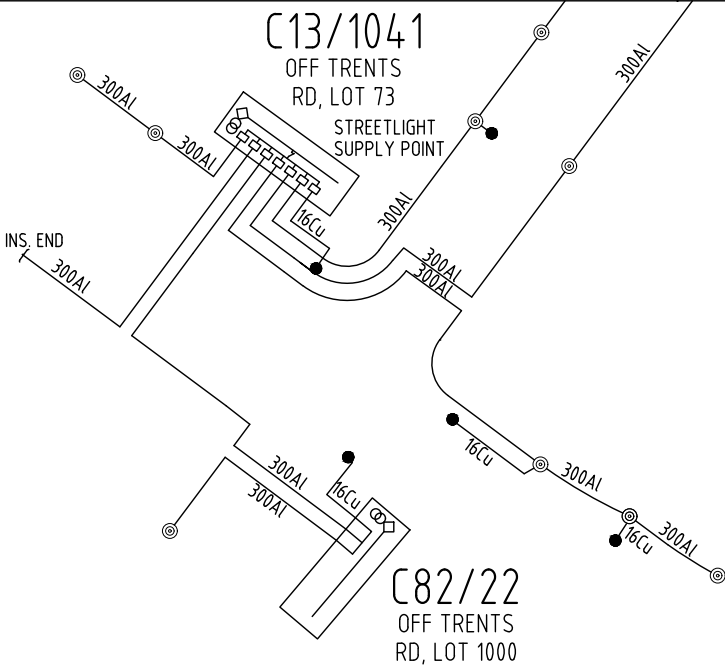


ACCEPTED

by Mark Williams on: 04 06 2026, 11:57 am

Orion

ISSUE	DESCRIPTION	DATE	DESIGN	DRAWN	CHECKD	TASK	NAME	SIGNATURE	DATED	232 HAMPTONS RD-STAGE 7B, 7C, 9A & 9C	 ALL WAYS CONNECTING	RESIDENCIAL SUBDIVISION SL SCHEMATICS - EXISTING	SCALE(SIZE)	DRAWING NO.	SHEET
A	ORIGINAL ISSUE	03/11/25	B.C	B.C	M.O	DESIGNED	B. CAVALCANTE		18/06/25				NTS(A3)	107004	SL-01
						DRAWN	B.CAVALCANTE		18/06/25						
						CHECKED	M.OPHUIS		03/11/25						
						APPROVED									
						ORN1008854	 CONNETICS LIMITED. ALL RIGHTS RESERVED UNAUTHORISED USE PROHIBITED		A						

PROPOSED

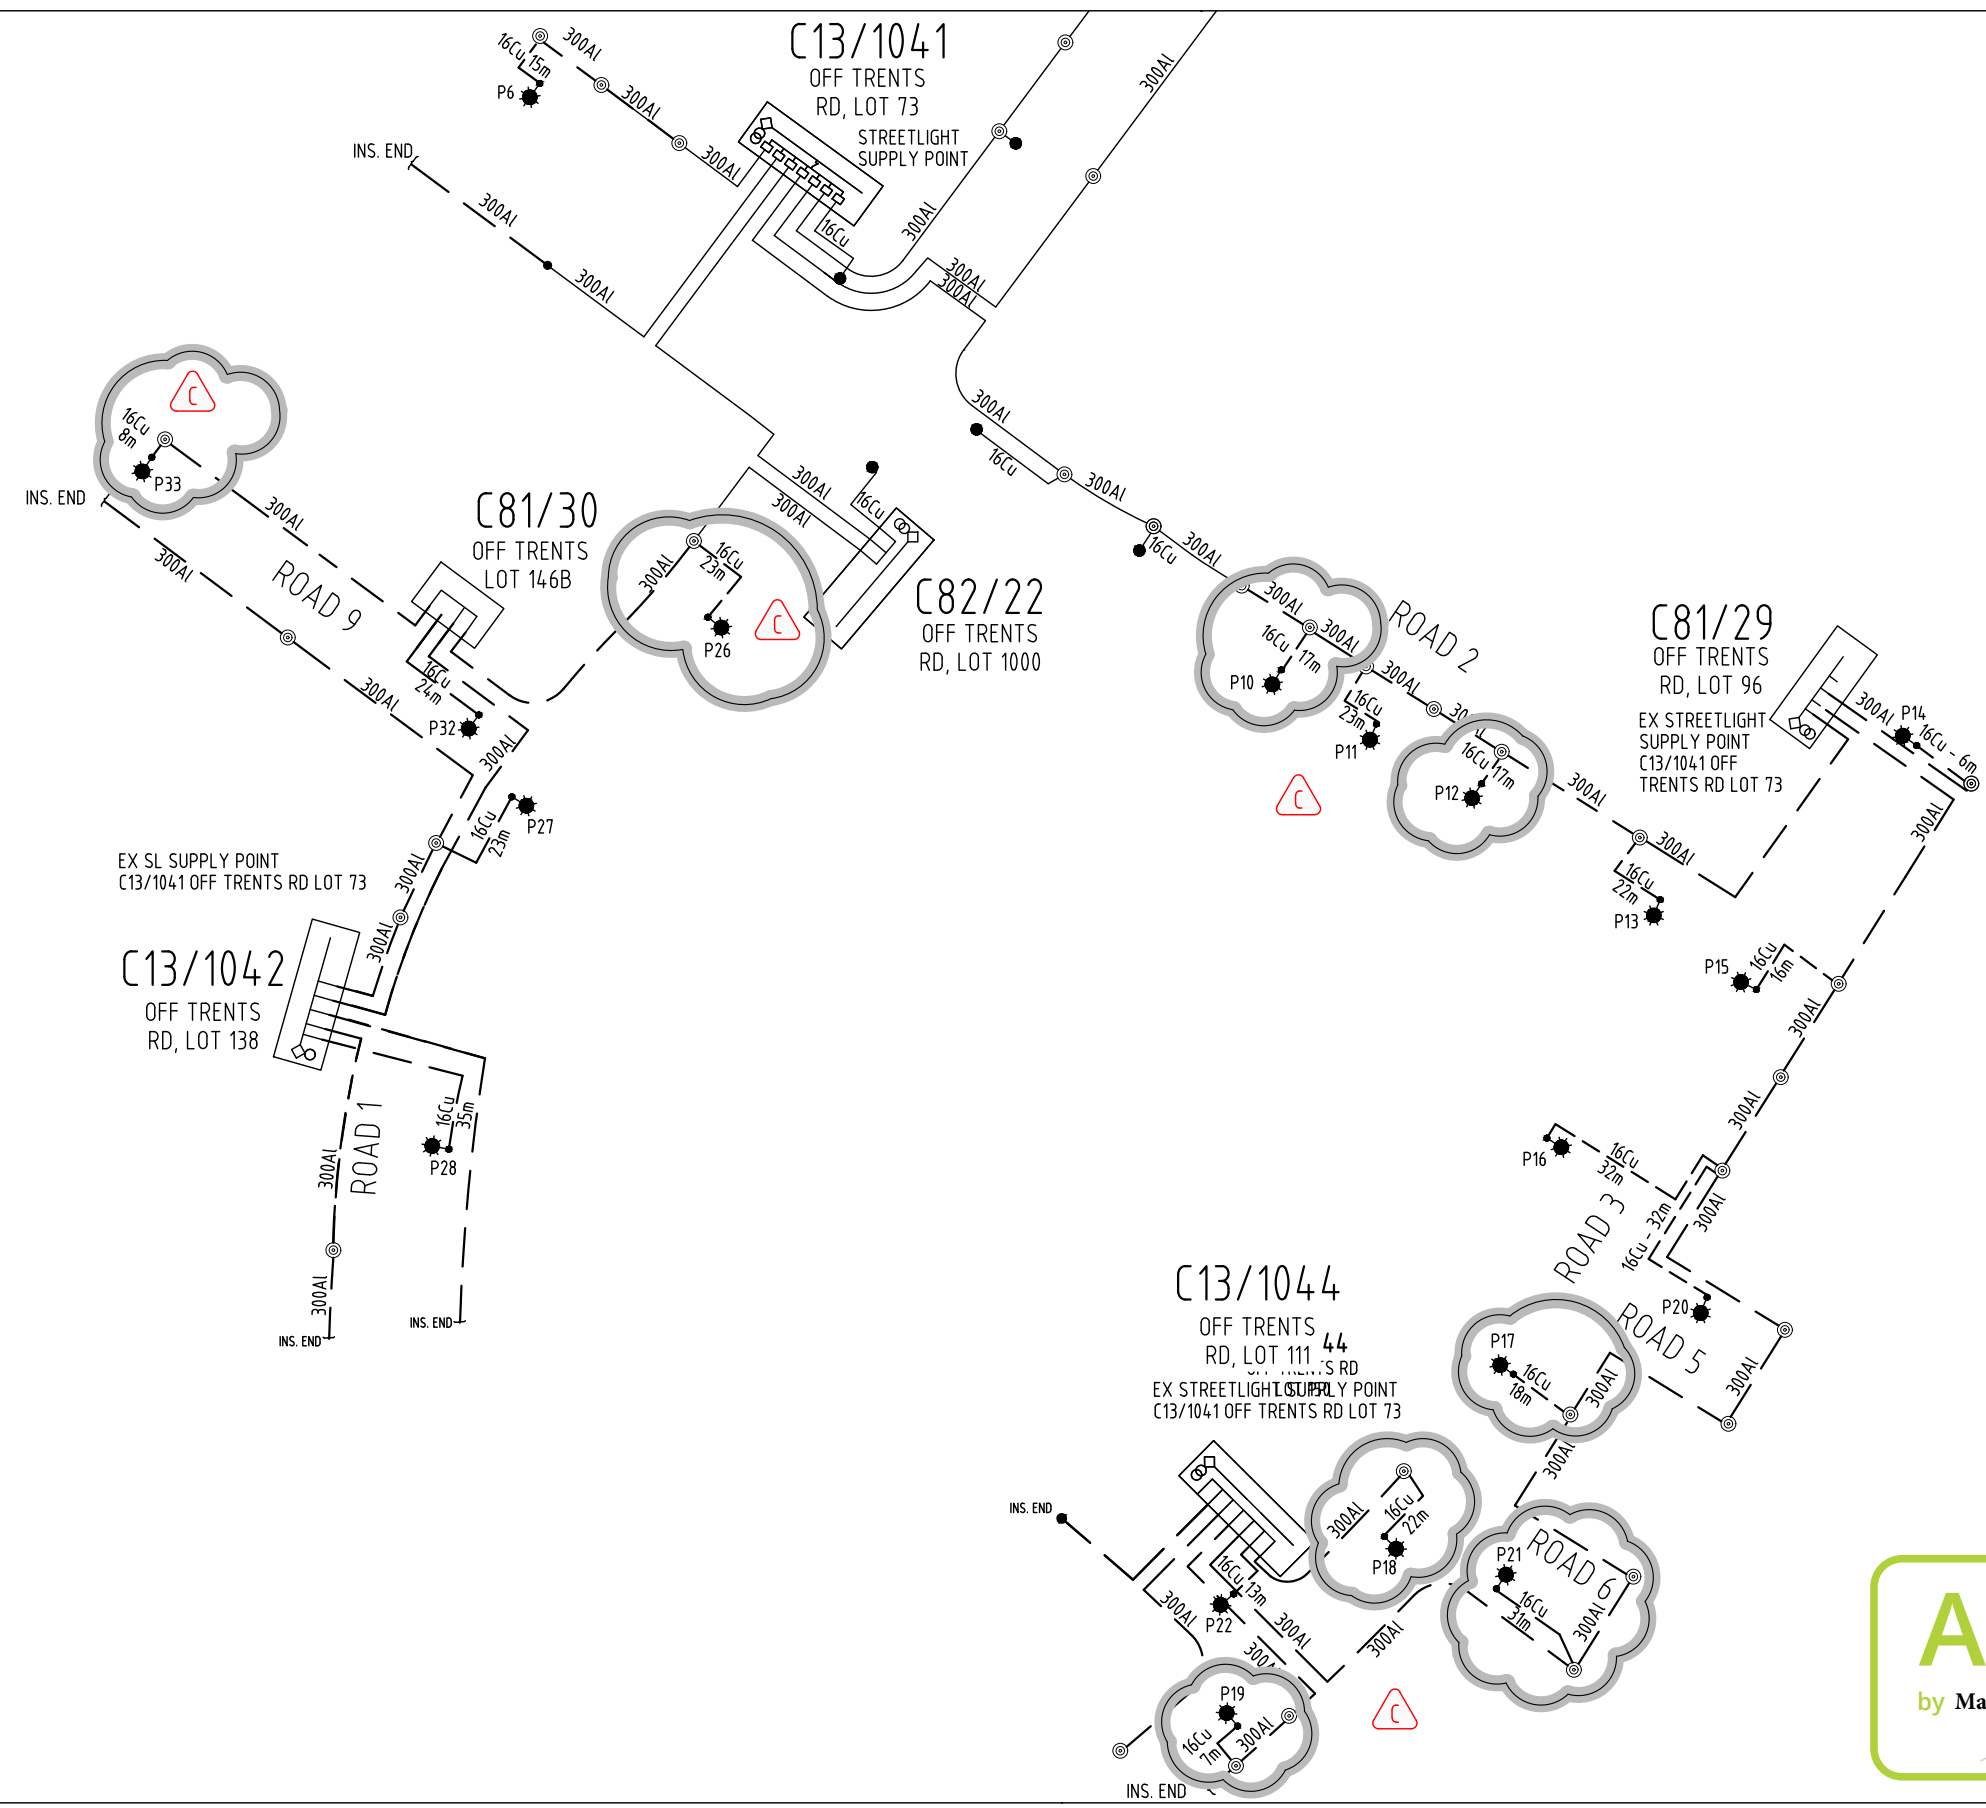


ACCEPTED
by Mark Williams on: 04 06 2026, 11:57 am
Orion

ISSUE	DESCRIPTION	DATE	DESIGN	DRAWN	CHECKD	TASK	NAME	SIGNATURE	DATED
A	ORIGINAL ISSUE	03/11/25	B.C	B.C	M.O	DESIGNED	B. CAVALCANTE		18/06/25
B	KIOSK MOVED TO NORTH OF LOT 96	24/11/25	B.C	B.C	M.O	DRAWN	B. CAVALCANTE		18/06/25
C	SL LOCATIONS UPDATED, STAGE 9C MODIFIED & STAGE 13 ADDED	03/06/26	B.C	B.C	M.O	CHECKED	M.OPHUIS		03/11/25
						APPROVED			
						ORN1008854	CONNETICS LIMITED. ALL RIGHTS RESERVED UNAUTHORISED USE PROHIBITED		C

232 HAMPTONS RD-STAGE 7B, 7C, 9A & 9C
RESIDENTIAL SUBDIVISION
SL SCHEMATICS - PROPOSED

		
SCALE(SIZE)	DRAWING NO.	SHEET
NTS(A3)	107004	SL-02

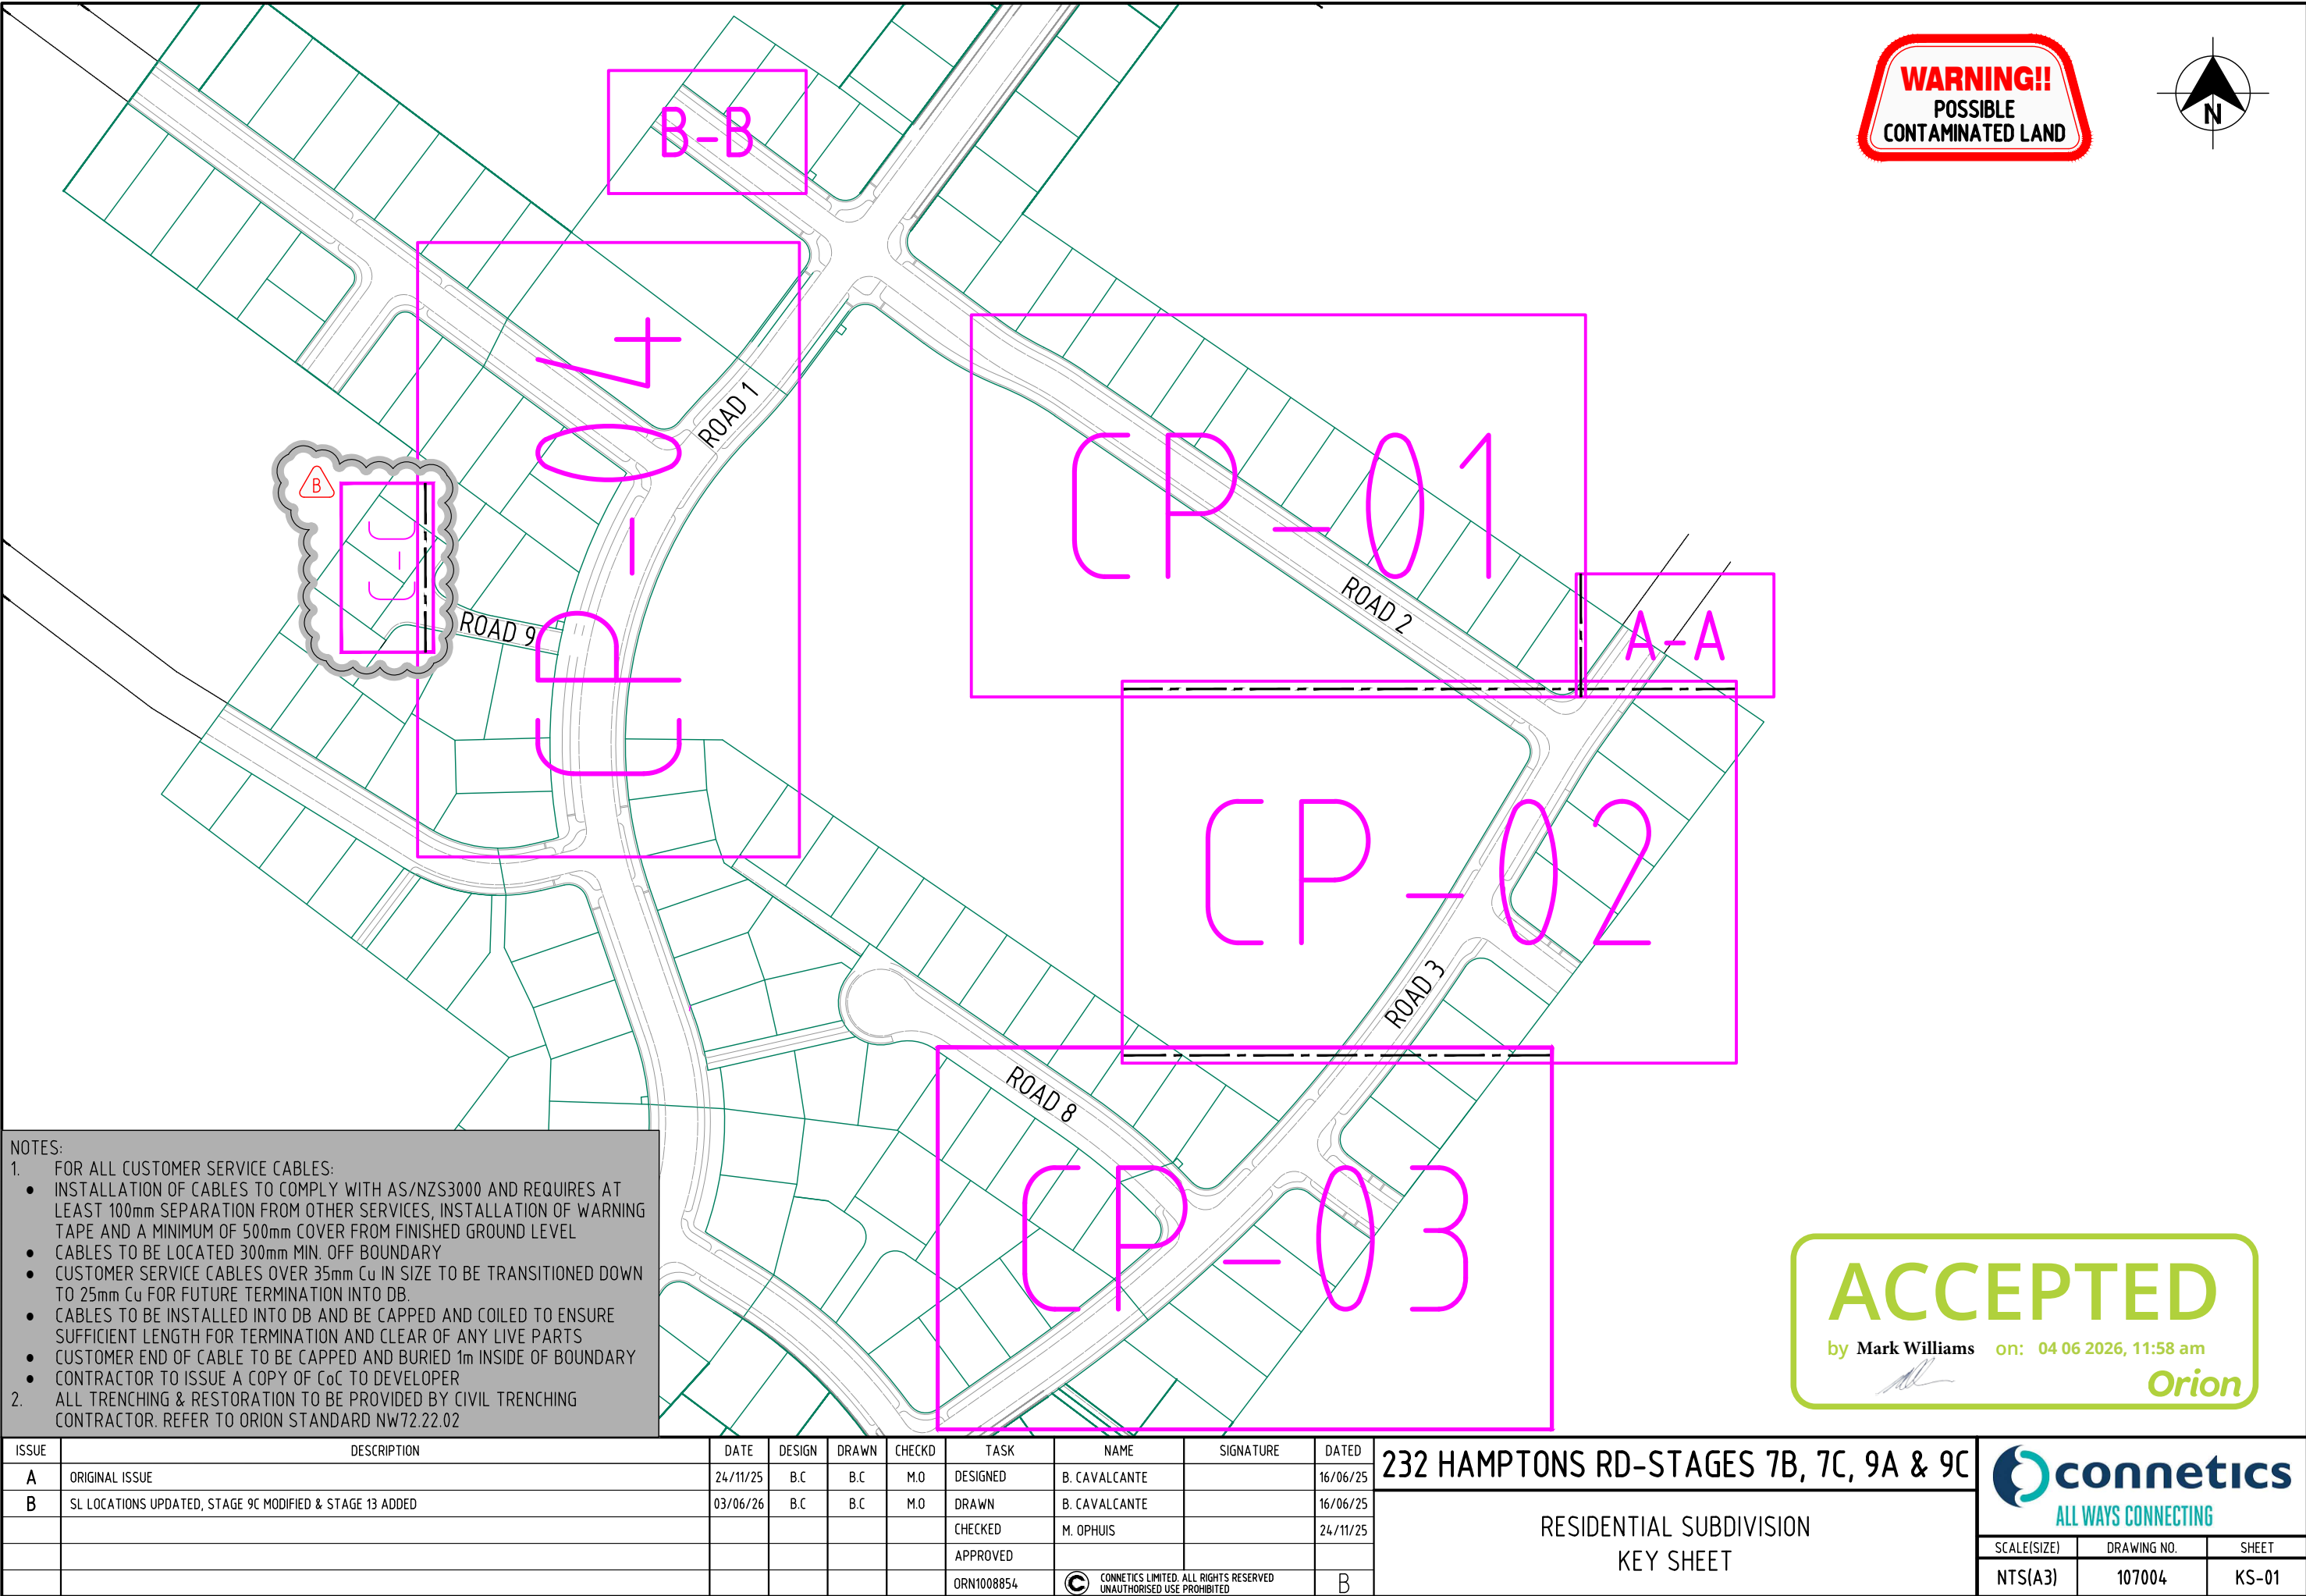

NOTES:

1. FOR ALL CUSTOMER SERVICE CABLES:

- INSTALLATION OF CABLES TO COMPLY WITH AS/NZS3000 AND REQUIRES AT LEAST 100mm SEPARATION FROM OTHER SERVICES, INSTALLATION OF WARNING TAPE AND A MINIMUM OF 500mm COVER FROM FINISHED GROUND LEVEL
- CABLES TO BE LOCATED 300mm MIN. OFF BOUNDARY
- CUSTOMER SERVICE CABLES OVER 35mm Cu IN SIZE TO BE TRANSITIONED DOWN TO 25mm Cu FOR FUTURE TERMINATION INTO DB.
- CABLES TO BE INSTALLED INTO DB AND BE CAPPED AND COILED TO ENSURE SUFFICIENT LENGTH FOR TERMINATION AND CLEAR OF ANY LIVE PARTS
- CUSTOMER END OF CABLE TO BE CAPPED AND BURIED 1m INSIDE OF BOUNDARY
- CONTRACTOR TO ISSUE A COPY OF CoC TO DEVELOPER

2. ALL TRENCHING & RESTORATION TO BE PROVIDED BY CIVIL TRENCHING CONTRACTOR. REFER TO ORION STANDARD NW72.22.02


ISSUE	DESCRIPTION	DATE	DESIGN	DRAWN	CHECKD	TASK	NAME	SIGNATURE	DATED
A	ORIGINAL ISSUE	24/11/25	B.C	B.C	M.O	DESIGNED	B. CAVALCANTE		16/06/25
B	SL LOCATIONS UPDATED, STAGE 9C MODIFIED & STAGE 13 ADDED	03/06/26	B.C	B.C	M.O	DRAWN	B. CAVALCANTE		16/06/25
						CHECKED	M. OPHUIS		24/11/25
						APPROVED			
						ORN1008854	CONNETICS LIMITED. ALL RIGHTS RESERVED UNAUTHORISED USE PROHIBITED		B

232 HAMPTONS RD-STAGES 7B, 7C, 9A & 9C

RESIDENTIAL SUBDIVISION
KEY SHEET

ALL WAYS CONNECTING

SCALE(SIZE)	DRAWING NO.	SHEET
NTS(A3)	107004	KS-01

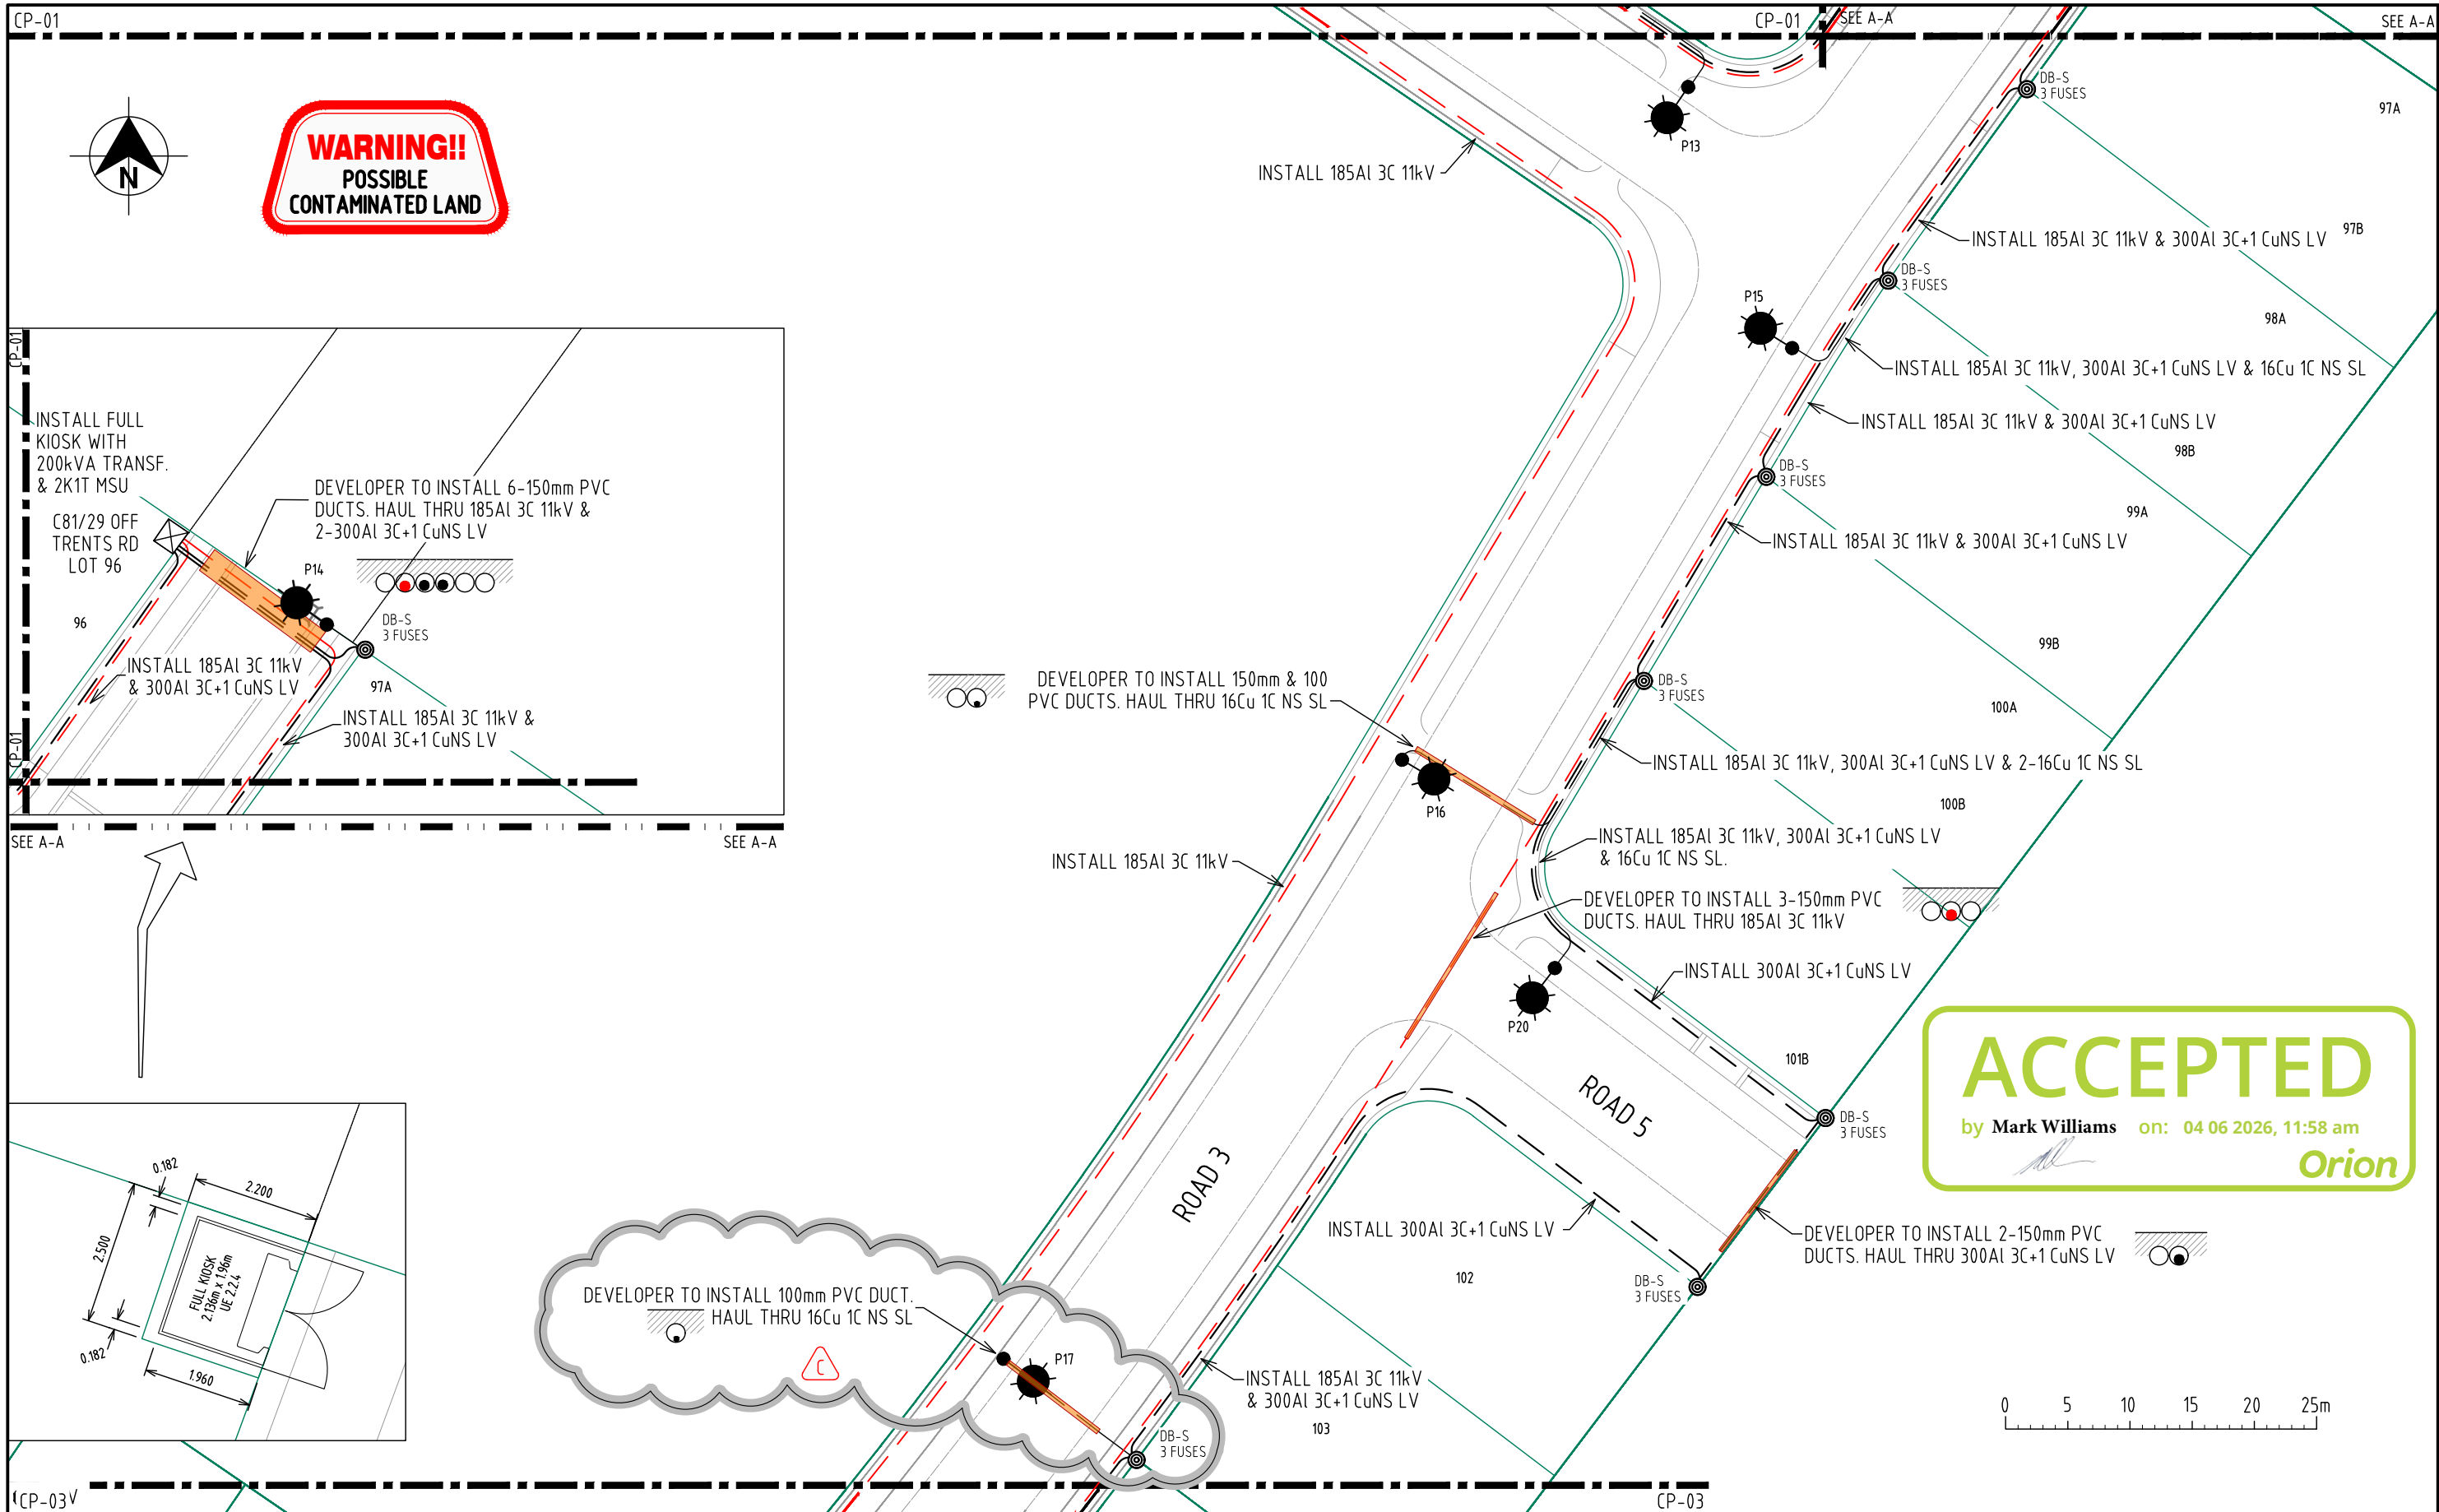


ISSUE	DESCRIPTION	DATE	DESIGN	DRAWN	CHECKD	TASK	NAME	SIGNATURE	DATED
A	ORIGINAL ISSUE	03/11/25	B.C	B.C	M.O	DESIGNED	B. CAVALCANTE		16/06/25
B	KIOSK MOVED TO NORTH OF LOT 96	24/11/25	B.C	B.C	M.O	DRAWN	B. CAVALCANTE		16/06/25
C	SL LOCATIONS UPDATED	03/06/26	B.C	B.C	M.O	CHECKED	M. OPHUIS		24/11/25
						APPROVED			
						ORN1008854	CONNETICS LIMITED. ALL RIGHTS RESERVED UNAUTHORISED USE PROHIBITED		C

232 HAMPTONS RD-STAGE 7B, 7C, 9A & 9C


RESIDENTIAL SUBDIVISION
CABLE PLAN


ALL WAYS CONNECTING

SCALE(SIZE)	DRAWING NO.	SHEET
1:500(A3)	107004	CP-02

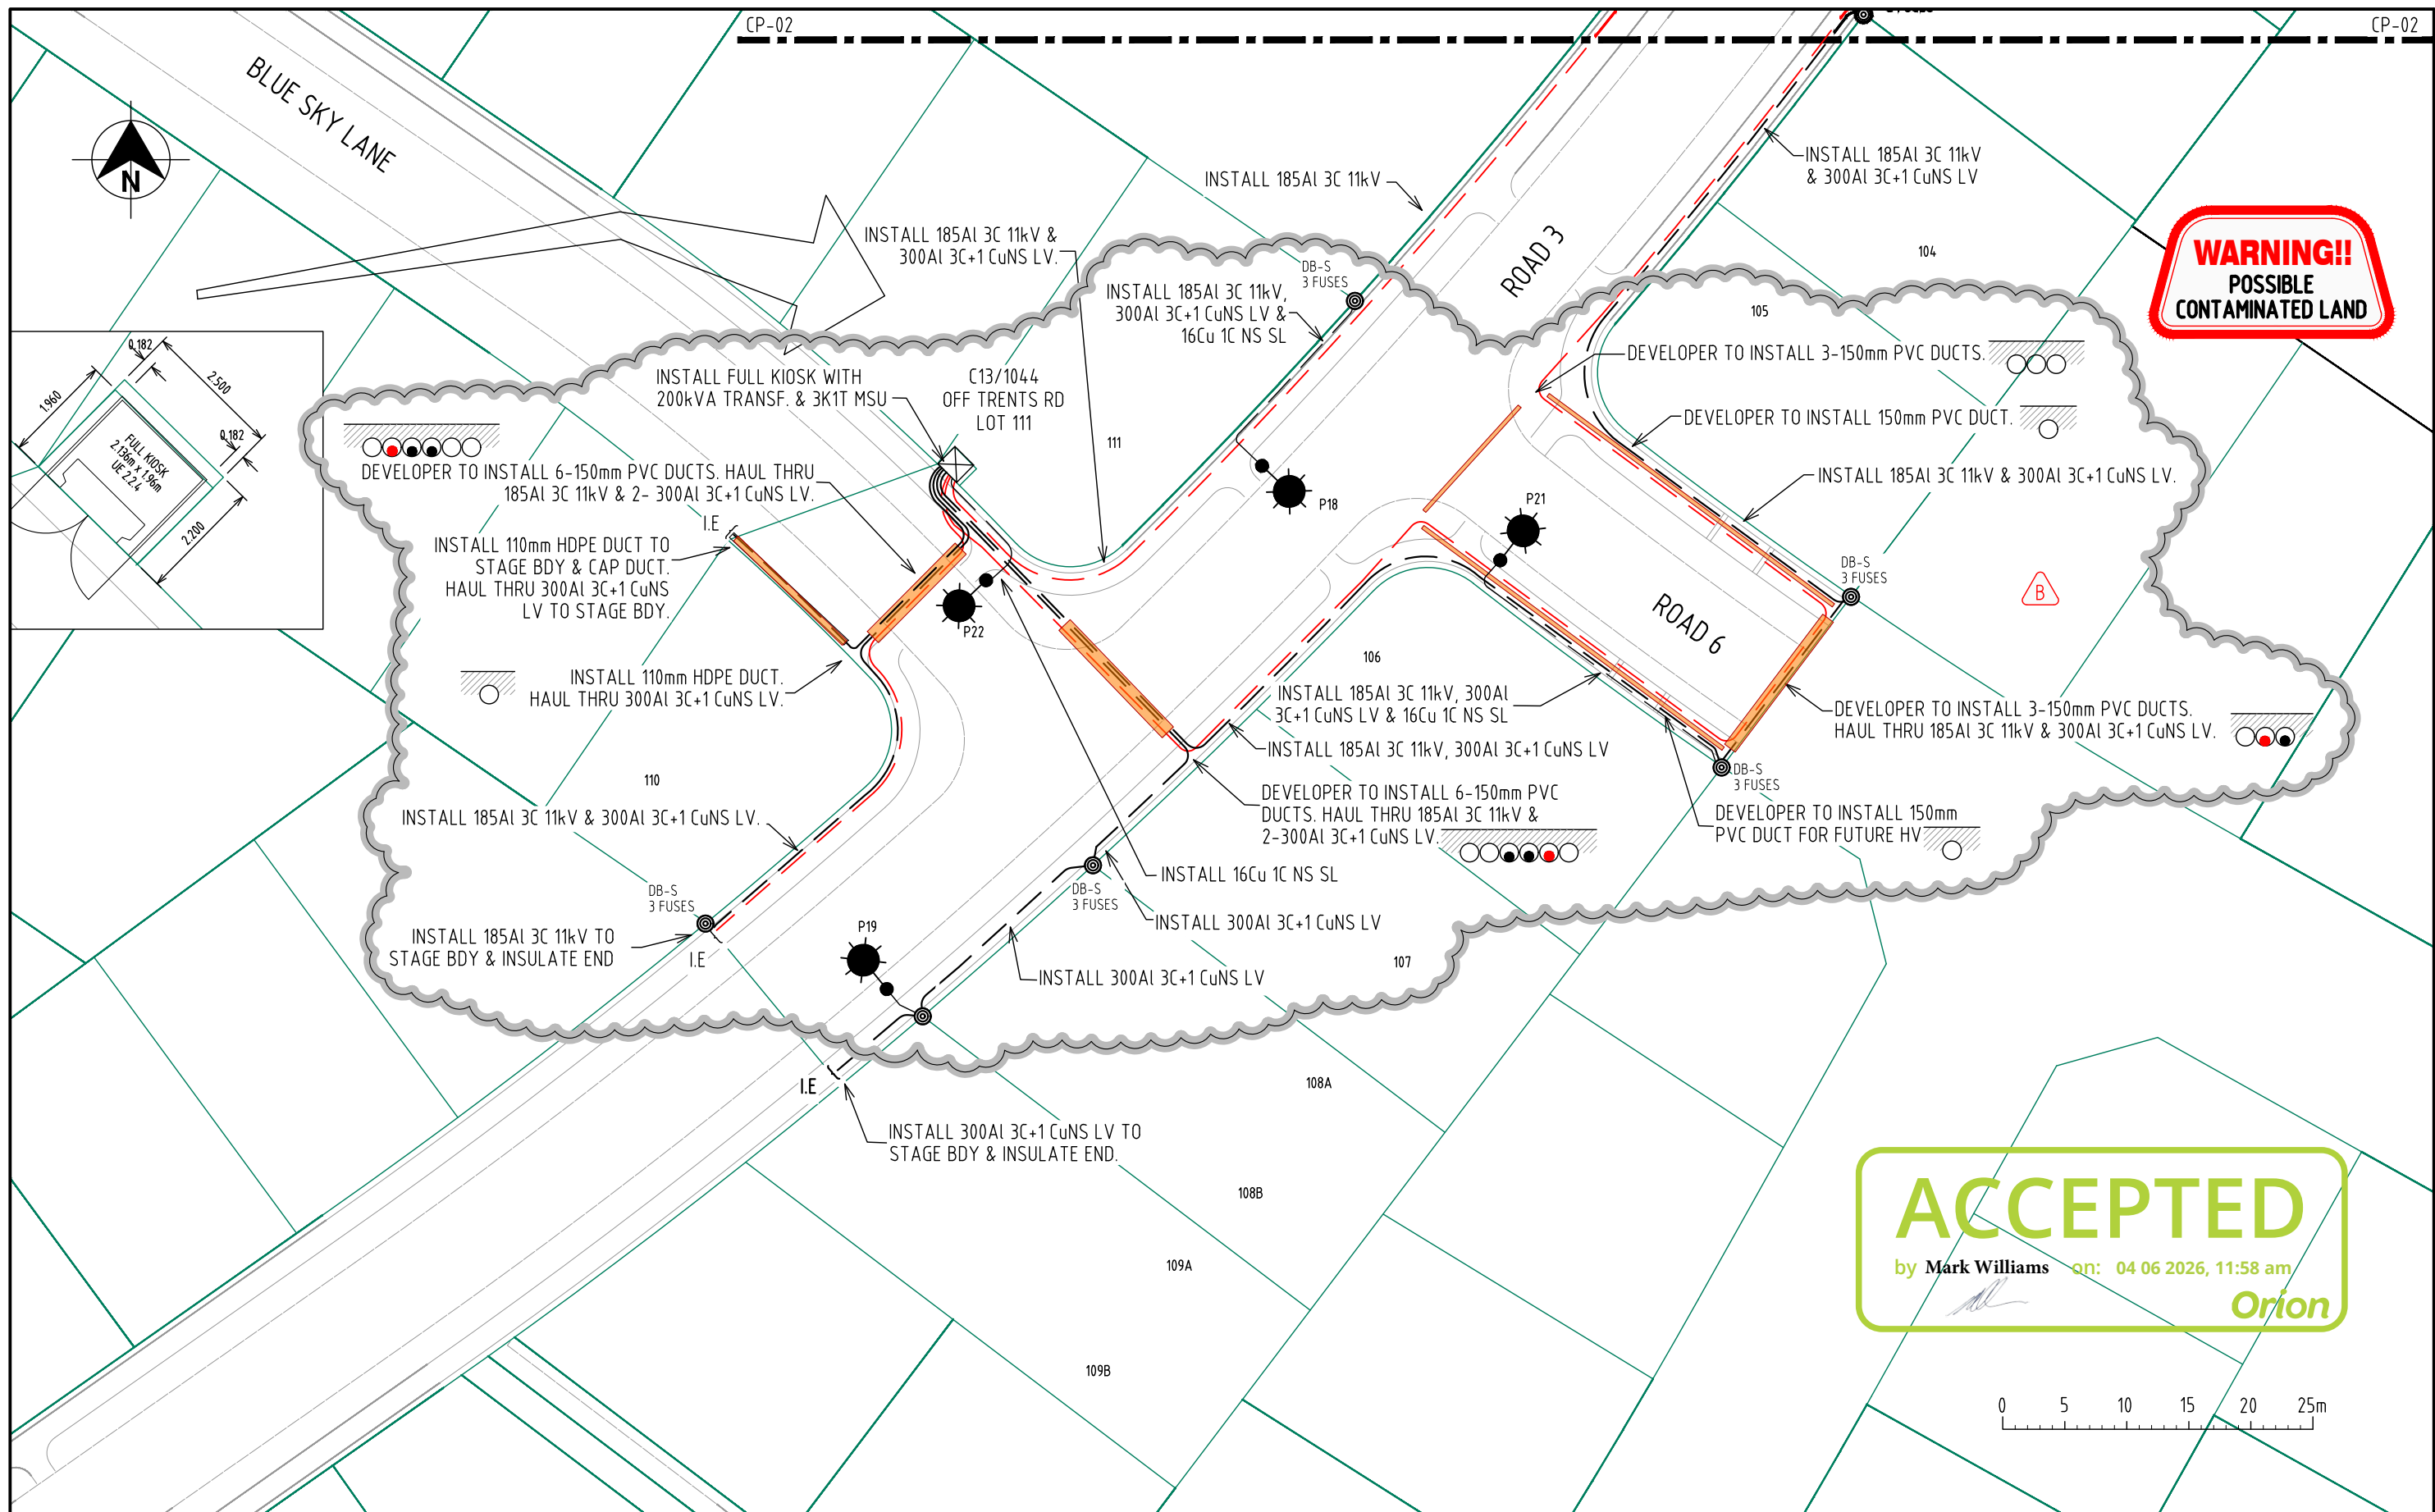

ISSUE	DESCRIPTION	DATE	DESIGN	DRAWN	CHECKD	TASK	NAME	SIGNATURE	DATED	232 HAMPTONS RD-STAGE 7B, 7C, 9A & 9C	 ALL WAYS CONNECTING			
A	ORIGINAL ISSUE	03/11/25	B.C	B.C	M.O	DESIGNED	B. CAVALCANTE		16/06/25					
B	SL LOCATIONS UPDATED & HV CABLE RELOCATED	03/06/26	B.C	B.C	M.O	DRAWN	B. CAVALCANTE		16/06/25					
						CHECKED	M. OPHUIS		03/11/25					
						APPROVED								
						ORN1008854	 CONNETICS LIMITED. ALL RIGHTS RESERVED UNAUTHORISED USE PROHIBITED		B	RESIDENTIAL SUBDIVISION CABLE PLAN				
												SCALE(SIZE)	DRAWING NO.	SHEET
												1:500(A3)	107004	CP-03

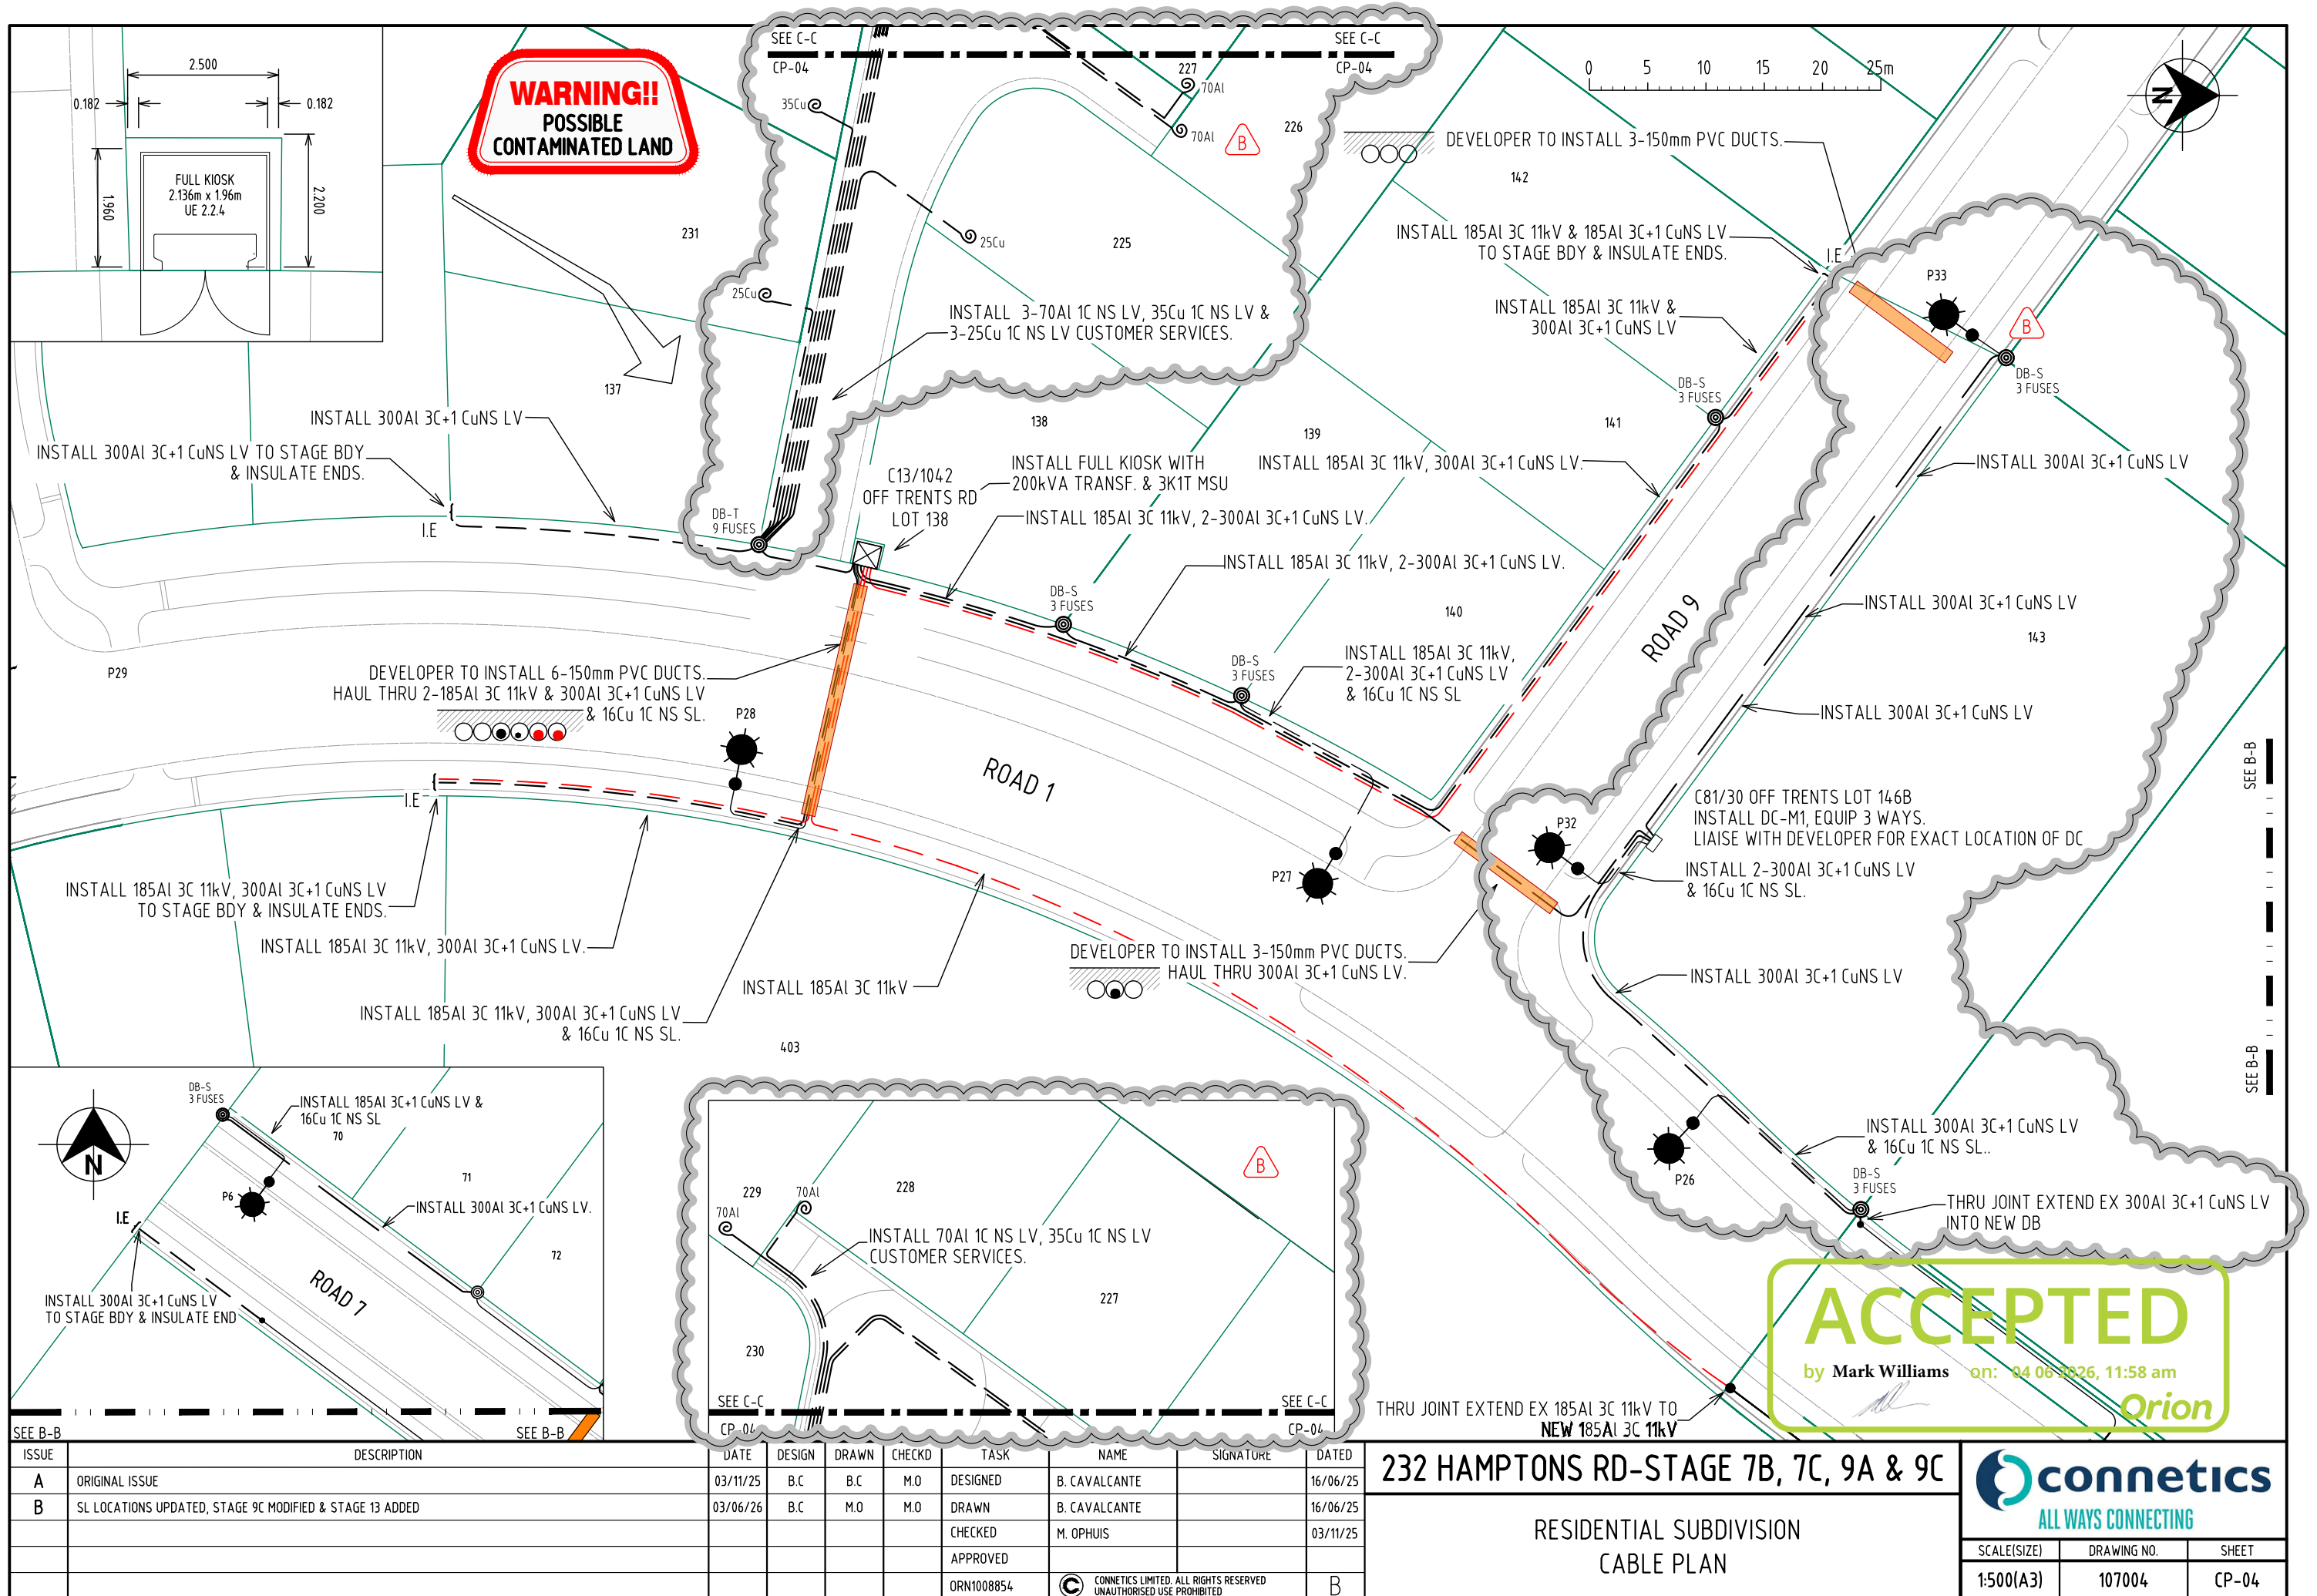

ISSUE	DESCRIPTION	DATE	DESIGN	DRAWN	CHECKD	TASK	NAME	SIGNATURE	DATED
A	ORIGINAL ISSUE	03/11/25	B.C	B.C	M.O	DESIGNED	B. CAVALCANTE		16/06/25
B	SL LOCATIONS UPDATED, STAGE 9C MODIFIED & STAGE 13 ADDED	03/06/26	B.C	M.O	M.O	DRAWN	B. CAVALCANTE		16/06/25
						CHECKED	M. OPHUIS		03/11/25
						APPROVED			
						ORN1008854			B

232 HAMPTONS RD-STAGE 7B, 7C, 9A & 9C

RESIDENTIAL SUBDIVISION
CABLE PLAN



ALL WAYS CONNECTING

SCALE(SIZE)	DRAWING NO.	SHEET
1:500(A3)	107004	CP-04

Hazard Register

 Design Hazard Assessment Register (HAZID)					Prepared By: Brenda Cavalcante		Date: 3 November 2025 Document: HAR-1 Status: Design REV A						
					Reviewed By: Mark Ophuis								
					HAZID Phase: Detailed Design (Includes Modifications)								
Project: 107004 - 232 Hamptons Rd - Stage 7B, 7C, 9A & 9C													
Identified Hazards, Causes & Risks Associated with Design/Redesign of new or existing Assets and/or Introduction of New Asset Types, or a change to the Operating Conditions of Assets					Proposed Risk Treatment/Mitigation Measures & Residual Risk Ratings							Notes to Residual Risk (Which Must be So Far As Is Reasonably Practicable and Manageable)	
ID	Risk/Hazard & Cause - Inherent & Without Any Form of Mitigation	Inherent Consequence	Inherent Likelihood	Inherent Risk Rating	Risk Owner	Proposed Mitigation (Eliminate or Minimise/Control) - Include Existing & Proposed Mitigation Measures	Revised Consequence	Revised Likelihood	Residual Risk Rating	Estimated Cost of Mitigation (\$)	Cost of Mitigation Disproportionate to Risk?	Risk Owner	Notes to Residual Risk
A - Planning & Conceptual Design													
A1		Minor	Rare	Low	N/A		Minor	Rare	Low	N/A	N/A	N/A	
B - Detailed Design (Includes Modifications)													
B1	Possible contaminated ground within work area	Moderate	Possible	Medium	Consultant	Consultant to note on drawings	Moderate	Rare	Low	N/A	No	Consultant	
C - Construction & Commissioning													
C1	Possible contaminated ground within work area	Moderate	Possible	Medium	Contractor	Contractor to take appropriate measures to ensure appropriate precautions are taken. i.e. PPE	Minor	Possible	Low	N/A	No	Contractor	
D - Operation & Maintenance													
D1	Possible contaminated ground within work area	Moderate	Possible	Medium	Contractor	Contractor to take appropriate measures to ensure appropriate precautions are taken. i.e. PPE	Minor	Possible	Low	N/A	No	Contractor	
E - Decommission & Disposal													
E1		Minor	Rare	Low	N/A		Minor	Rare	Low	N/A	N/A	N/A	
Notepad - Use this space to describe the Project, any further information that cannot be described in the hazards above, and any other information that is important to document as part of the Safety in Design assessment													



APPENDIX A: DESIGN STATEMENT OF ENVIRONMENTAL COMPLIANCE

Work Order:		
Work Title:	107004 - 232 Hamptons Rd - Stage 7B, 7C, 9A & 9C	
Are the proposed earthworks:	Yes/No (circle one)	
1. Excluded under the global earthworks consent (refer section 4.1 and 4.2)?	Yes / No	
2. In a Ground Contamination Risk Area?	Yes / No	
3. In an Archaeology Area?	Yes / No	
4. In a Cultural Significance Area?	Yes / No	
5. Within 10m to the bed of a waterway identified as a Critical Habitat?	Yes / No	
Where any of the above questions 2 – 5 have been ticked 'yes', has the proposed management / controls to proceed with works been accepted by Orion?	Yes / No	
The design submitted to Orion complies with the Global Earthworks Consents requirements.		
Name:	Brenda Cavalcante	
Signed:	<i>Brenda Cavalcante</i>	
Company:	Connetics Ltd	
Date:	03/11/2025	

Issue Date 26.06.2020 NW70.10.31 Next Review 26.06.2025 24 of 39 Amendment 0



Build Quotation for electrical reticulation at:
232 Hamptons Rd Stage 7B, 7C, 9A & 9C
Urban Estates
c/o Ben Fox (DLS)
email: Ben.Fox@dls.co.nz

FROM ORION AUTHORISED ELECTRICAL CONTRACTOR:

Refer to the Orion accepted Connetics design dwg 107004 shts CP-01, CP-02, CP-03 & CP-04 Work instruction sheets and schematics.

Quotation required by: _____

Schedule of prices:

1) 11kV CABLES & JOINTING

Supply and install 11kV cable, jointing and terminations
HV programs, cable tests, certification and livening

2) LV RETICULATION, CABLES & JOINTING

Supply and install cables, distribution cabinets and distribution boxes
Cable terminations and jointing (include all SL cables)
Test and LVA

3) STREET LIGHTS

Refer to Spunlite street light design dwg 400332
Install 19 street lights, including livening and associated documentation

4) SUBSTATIONS

Install three full kiosks, refer to WIS. Include earthing.
Test earthing to ensure compliance.

5) CUSTOMER SERVICE CABLES

Lay in customer service cables (25Cu 1C, 35Cu 1C & 70Al 1C) into new DB and terminate.

TOTAL (EXCLUDES GST)

NOTES:

Allow for as built cable recording, to be sent directly to Orion.
All trenching and restoration provided by the Developer except where identified.
Assume Temporary Traffic Management is the responsibility of others□

Designer:	Brenda Cavalcante	Date:	03/06/2026
Design number:	107004	Job name:	232 HAMPTONS RD-STAGE 7B, 7C, 9A & 9C
Approx. start date:		Developer:	
Orions Contract	ORN1008854	Design/Build:	
Orion Contact	Mark Williams	Design Only:	Yes

These quantity estimations are based on the CAD file and are for pricing purposes only. Actual quantities may vary on site.

Stock number	Description	Quantity (m)	Special requirements
1003401	6mm Cu 2ph NS LV	0	
1003402	16mm Cu 1ph NS LV	386	
1003403	16mm Cu 2ph NS LV	0	
1003404	16mm Cu 3ph NS LV	0	
1003405	25mm Cu 1ph NS LV	118	
1003406	25mm Cu 3ph NS LV	0	
1001995	35mm Cu 1ph NS LV	46	
1003407	35mm Cu 3ph NS LV	0	
1008940	70mm Al 1C NS LV	279	
1002009	95mm Al 1C NS LV	0	
1003397	120mm Ali 3ph NS +10mm LV	0	
1003398	185mm Ali 3ph NS +10mm LV	0	
1003399	300mm Ali 3ph NS +10mm LV	1442	
1003400	400mm 1c Cu XLPE	0	
1003383	25mm 1c XLPE 11KV	0	
1003384	35mm Ali 3ph XLPE 11KV	0	
1003386	95mm Ali 3ph XLPE 11KV	0	
1003387	185mm Ali 3ph XLPE 11KV	1335	
1003390	300mm Ali 3ph XLPE 11KV	0	
1009939	400mm Cu 3ph XLPE 11KV	0	
1003389	185mm 1c Cu 11KV	0	
1006345	95mm 1c AL XLPE 11KV	0	
1003394	300Al 1c 33kV	0	
1003423	25pr 0.9mm PAC PE SWA	0	
1003422	7pr 0.9mm PAC PE SWA	0	
1007115	Distribution Box S - 6 way	25	
1007156	Distribution Box T - 9 way	1	
1012372	DB-U (replaces DB-S & DB-T)	0	
1012376	DB-V (replaces DB-T1)	0	
1001152	Multi Box DC	1	
1000128	Full kiosk	3	
1000129	Half kiosk	0	
1000130	Quarter kiosk	0	