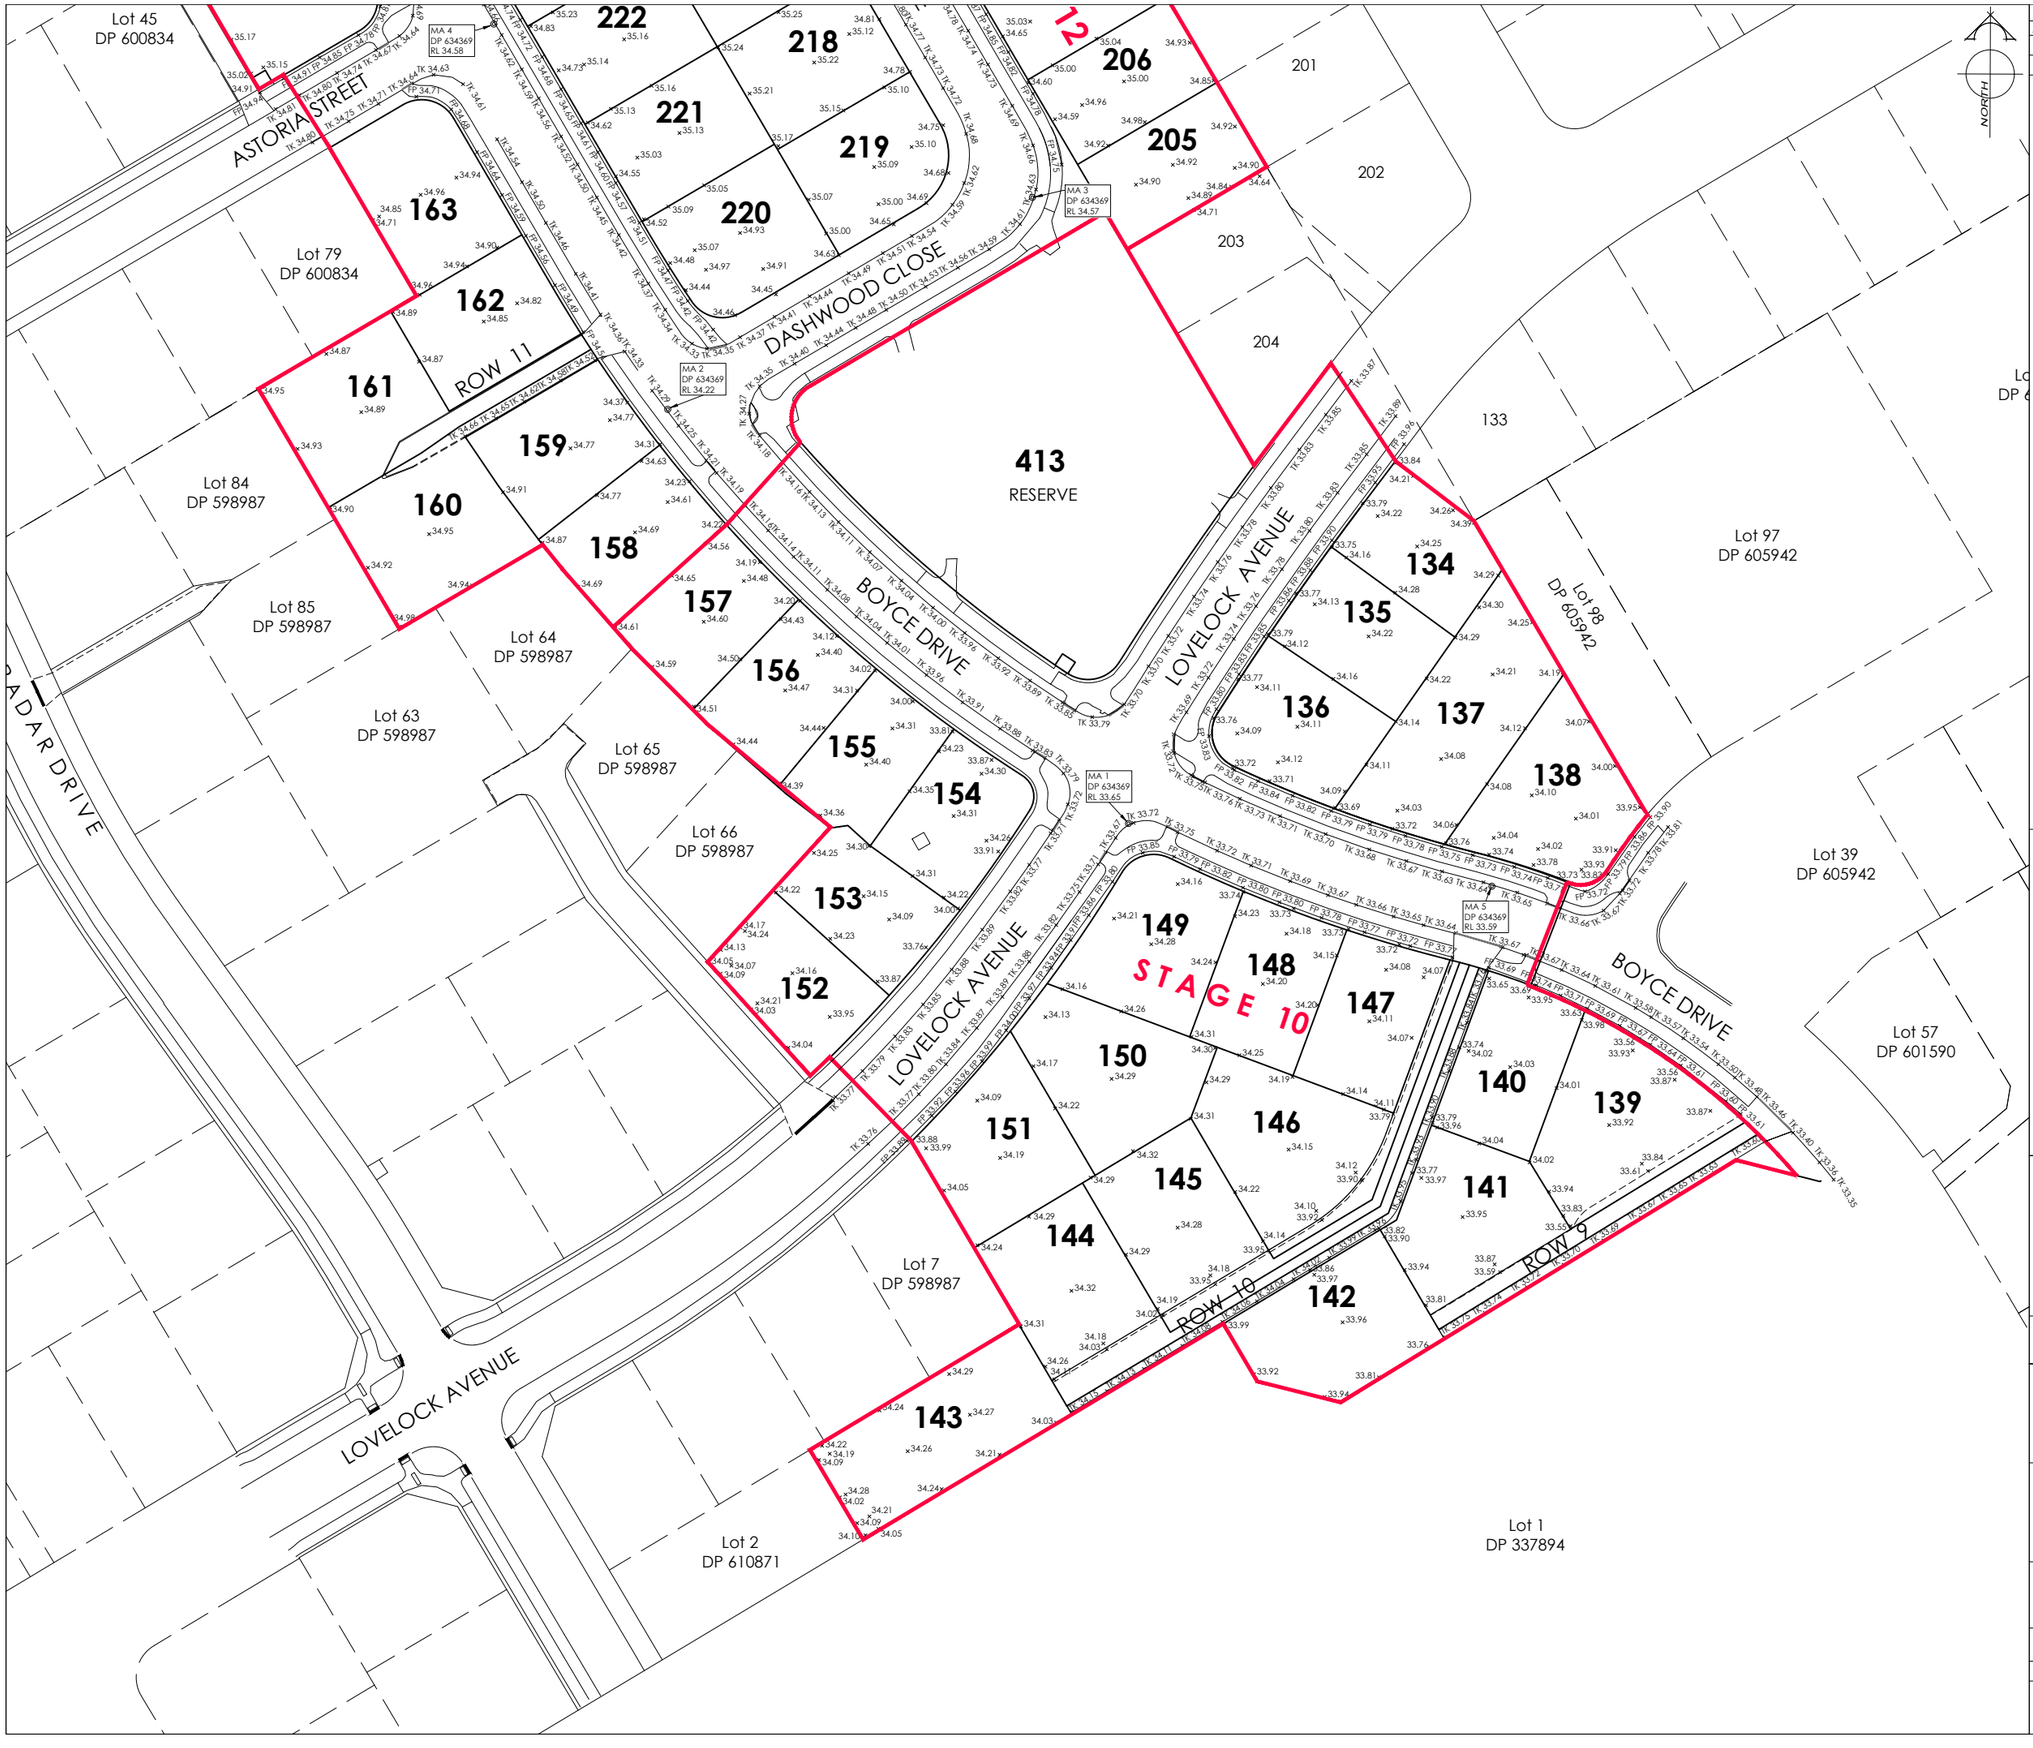

AMENDMENTS :

AMENDMENT	DATE	DESCRIPTION
R1	24.9.26	ADDITIONAL LEVELS ADDED

NOTES:

1) THIS PLAN HAS BEEN PREPARED FOR EARTH FILL ASBUILT PURPOSES ONLY. NO LIABILITY IS ACCEPTED IF THE PLAN IS USED FOR ANY OTHER PURPOSE.

2) ANY MEASUREMENTS TAKEN FROM INFORMATION WHICH IS NOT DIMENSIONED ON THE ELECTRONIC COPY ARE AT THE RISK OF THE RECIPIENT.

3) ALL ROADING INFORMATION IS ASBUILT.

4) ORIGIN OF LEVELS
LEVELS ARE IN TERMS OF NEW ZEALAND VERTICAL DATUM 2016

ORIGIN MARK B882 (UG 32)
RL 55.598m

Origin of Levels:
Levels are in terms of New Zealand Vertical Datum 2016 (NZVD 2016)

LEGEND

1:100	GRADE
x19.77	GROUND LEVEL
xTB 19.77	TOP OF BANK LEVEL
xTK 19.77	TOP OF KERB LEVEL
xTW 19.77	TOP OF WALL LEVEL
xFP19.77	FOOTPATH LEVEL
xINV19.77	INVERT LEVEL
xTKS 19.77	TOP OF SUMP LEVEL
ASBUILT KERB	
INVERT OF SWALE	
TOP OF BANK	

DAVIE LOVELL-SMITH
PLANNING SURVEYING ENGINEERING

116 Wrights Road P O Box 679 Christchurch 8140. New Zealand
Telephone: 03 379-0793 Website: www.dls.co.nz E-mail: office@dls.co.nz

JOB TITLE:

Broadfield Grange Stage 10

SHEET TITLE:

Lot Levels Asbuilt

DRAWING STATUS

Asbuilt

SCALE : 1:500@A1 1:1000@A3

DATE : September 2026

CAD FILE :J:\21489\AS BUILTS\E21489_STG10.12.13_ABLL_NZVD_R1.dwg

DRAWN :SBL

DRAWING No : **E.21489.AB.LL STG 10**

SHEET No:

REVISION : **R1**

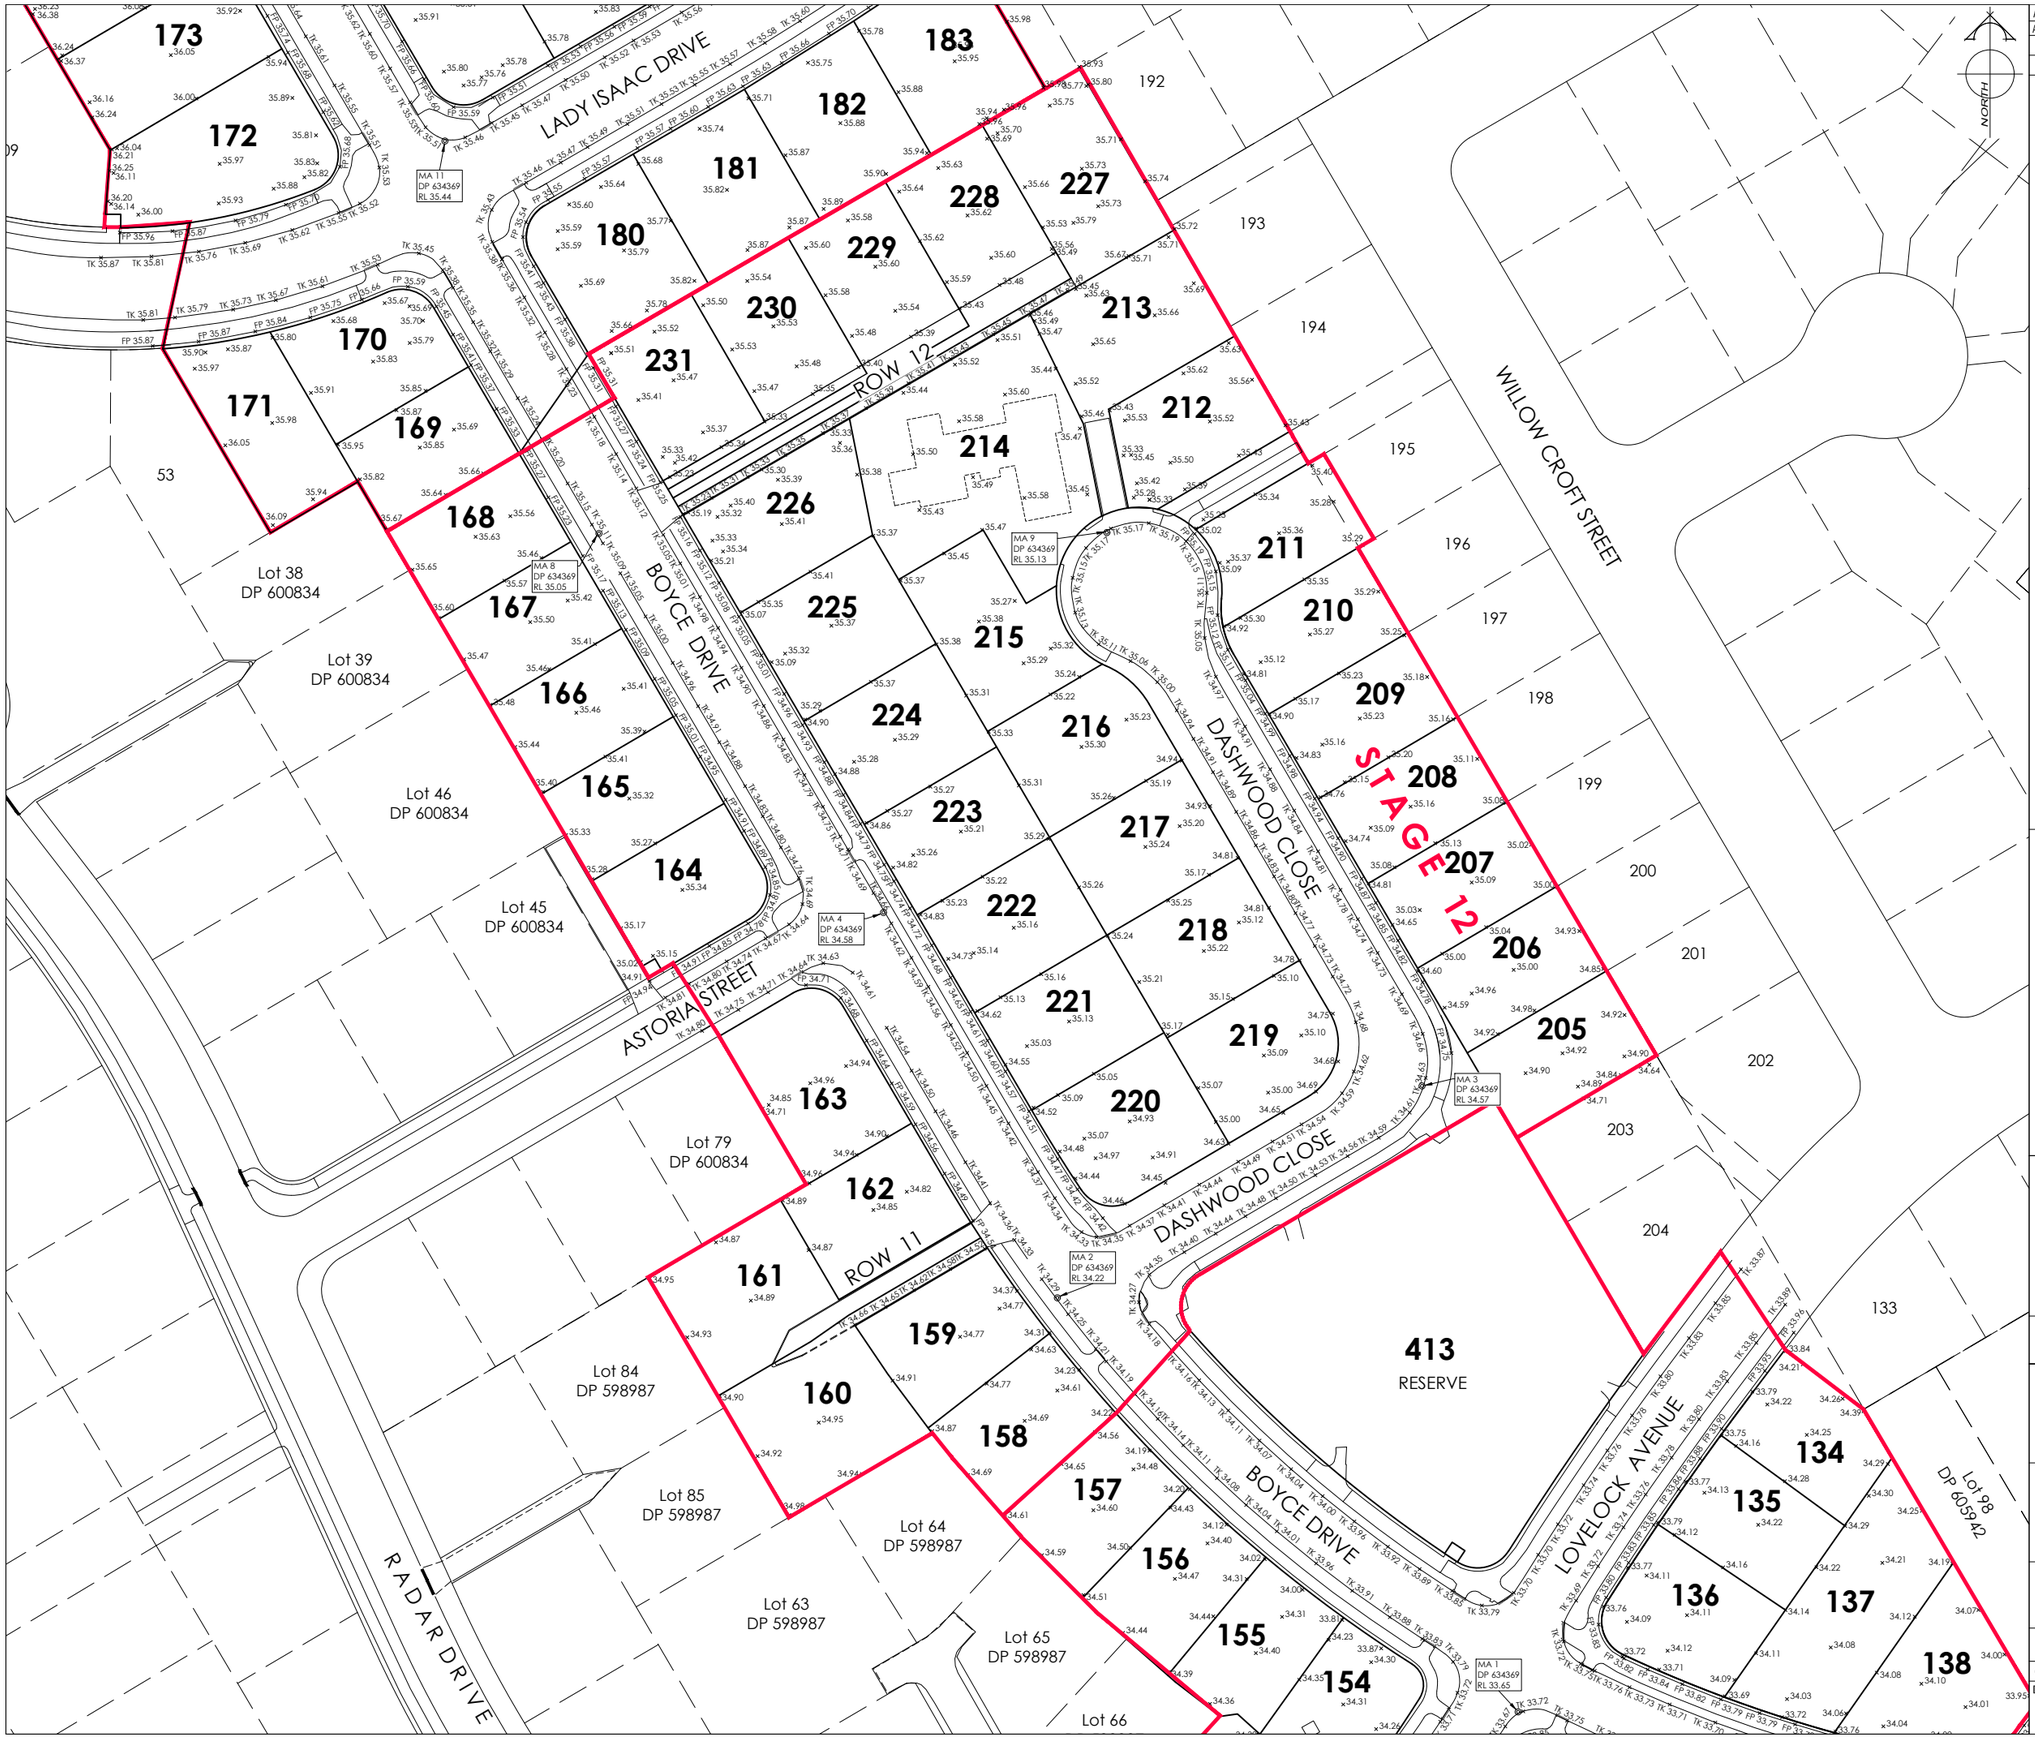

AMENDMENTS :

AMENDMENT	DATE	DESCRIPTION
R1	24.9.26	ADDITIONAL LEVELS ADDED

NOTES:

1) THIS PLAN HAS BEEN PREPARED FOR EARTH FILL ASBUILT PURPOSES ONLY. NO LIABILITY IS ACCEPTED IF THE PLAN IS USED FOR ANY OTHER PURPOSE.

2) ANY MEASUREMENTS TAKEN FROM INFORMATION WHICH IS NOT DIMENSIONED ON THE ELECTRONIC COPY ARE AT THE RISK OF THE RECIPIENT.

3) ALL ROADING INFORMATION IS ASBUILT.

4) ORIGIN OF LEVELS
LEVELS ARE IN TERMS OF NEW ZEALAND VERTICAL DATUM 2016

ORIGIN MARK B882 (UG 32)
RL 55.598m

Origin of Levels:
Levels are in terms of New Zealand Vertical Datum 2016 (NZVD 2016)

LEGEND

1:100	GRADE
x19.77	GROUND LEVEL
xTB 19.77	TOP OF BANK LEVEL
xTK 19.77	TOP OF KERB LEVEL
xTW 19.77	TOP OF WALL LEVEL
xFP19.77	FOOTPATH LEVEL
xINV19.77	INVERT LEVEL
xTKS 19.77	TOP OF SUMP LEVEL
ASBUILT KERB	
INVERT OF SWALE	
TOP OF BANK	

DAVIE LOVELL-SMITH
PLANNING SURVEYING ENGINEERING

116 Wrights Road P O Box 679 Christchurch 8140. New Zealand
Telephone: 03 379-0793 Website: www.dls.co.nz E-mail: office@dls.co.nz

JOB TITLE:
Broadfield Grange Stage 12

SHEET TITLE:
Lot Levels Asbuilt

DRAWING STATUS
Asbuilt

SCALE : 1:500@A1 1:1000@A3 DATE : September 2026

CAD FILE :J:\21489\AS BUILTS\E21489_STG10,12,13_ABLL_NZVD_R1.dwg DRAWN :SBL

DRAWING No : E.21489.AB.LL SHEET No: STG12 REVISION : R1



AMENDMENTS :

AMENDMENT	DATE	DESCRIPTION
R1	24.9.26	ADDITIONAL LEVELS ADDED

NOTES:

1) THIS PLAN HAS BEEN PREPARED FOR EARTH FILL ASBUILT PURPOSES ONLY. NO LIABILITY IS ACCEPTED IF THE PLAN IS USED FOR ANY OTHER PURPOSE.

2) ANY MEASUREMENTS TAKEN FROM INFORMATION WHICH IS NOT DIMENSIONED ON THE ELECTRONIC COPY ARE AT THE RISK OF THE RECIPIENT.

3) ALL ROADING INFORMATION IS ASBUILT.

4) ORIGIN OF LEVELS
LEVELS ARE IN TERMS OF NEW ZEALAND VERTICAL DATUM 2016

ORIGIN MARK B882 (UG 32)
RL 55.598m

Origin of Levels:
Levels are in terms of New Zealand Vertical Datum 2016 (NZVD 2016)

LEGEND

1:100 GRADE

×19.77 GROUND LEVEL
×TB 19.77 TOP OF BANK LEVEL
×TK 19.77 TOP OF KERB LEVEL
×TW 19.77 TOP OF WALL LEVEL
×FP19.77 FOOTPATH LEVEL
×INV19.77 INVERT LEVEL
×TKS 19.77 TOP OF SUMP LEVEL

ASBUILT KERB
INVERT OF SWALE
TOP OF BANK

DAVIE LOVELL-SMITH
PLANNING SURVEYING ENGINEERING

116 Wrights Road P O Box 679 Christchurch 8140. New Zealand
Telephone: 03 379-0793 Website: www.dls.co.nz E-mail: office@dls.co.nz

JOB TITLE:
Broadfield Grange Stage 13

SHEET TITLE:
Lot Levels Asbuilt

DRAWING STATUS
Asbuilt

SCALE : 1:500@A1 1:1000@A3 DATE : September 2026

CAD FILE J:\J\21489\AS BUILTS\E21489_STG10,12,13_ABLL_NZVD_R1.dwg DRAWN :SBL

DRAWING No : **E.21489.AB.LL STG 13** SHEET No: REVISION : **R1**